

MISSISSIPPI DEPARTMENT OF NATURAL RESOURCES

Bureau of Land and Water Resources

Southport Mall

P.O. Box 10631

Jackson, Mississippi 39209

COASTAL DRILLING & SERVICE DRILLERS LOG

HARRISON
M 2442
3/9/85

3/9/85 19 DE. 11, BOX 81 Harrison
date well completed DT. 11, BOX 81 name
BLOOM, MS 39532 county well located

LANDOWNER: Danny Hood
Rt. 3 Box 20
Bloom, MS
(mailing address)

description of formations encountered	from to	
top soil	1	3
sugar sand	3	20
red clay	20	72
fine water sand	72	82
good water sand	82	92

WELL LOCATION:
sec. 3 T. 6^N S. R. 10 E W
Bloom (distance) miles of (direction) (nearest town)

WELL PURPOSE: home
(home, irrigation, municipal, industrial)

- WELL COMPLETION DATA:
- (1) diameter (inches) 2"
 - (2) total depth (feet) 92
 - (3) static water level (feet) 10.52 below above top of ground.
 - (4) casing PVC, 82 (material) (depth)
(size) If telescope see back.
 - (5) screen 10, 82 (length) (depth to top)
2", PVC (size) (material)
 - (6) pump 1, 12 (HP) (yield gpm)
E.C. (type power)
 - (7) electric log NO (yes or no)
(organization running log)
 - (8) how well bottom plugged 2" back washline 1983


DRILLERS REMARKS: Si

RECEIVED
AUG 27 1985

MISSISSIPPI DEPARTMENT OF NATURAL RESOURCES
BUREAU OF LAND AND WATER RESOURCES

If well telescopes please sketch and show depths.

GROUND LEVEL

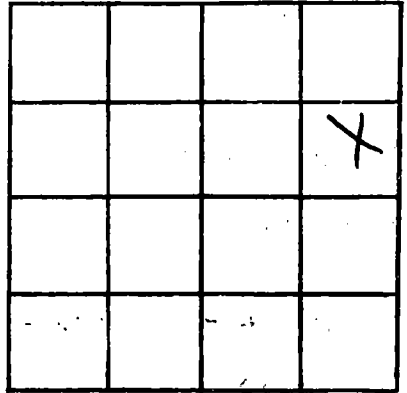

SECTION _____

Please indicate well location X.

ADDITIONAL INFORMATION

Multiple horizontal lines for writing additional information.

If more than one screen, show locations of each on sketch.