

MISSISSIPPI DEPARTMENT OF NATURAL RESOURCES

Bureau of Land and Water Resources

Southport Mall

P.O. Box 10631

Jackson, Mississippi 39209

WATER WELL DRILLERS LOG

HARRISON
M 2443

date well completed 3/11/85 19 Lyman Well Co. firm name Harrison county well located

LANDOWNER: Treated Materials
P.O. Box 2848
Gulfport, MS 39503
(mailing address)

Description of formations encountered	from	to
<u>Washed chip sand</u>	<u>0-</u>	<u>20</u>
<u>white clay</u>	<u>20-</u>	<u>60</u>
<u>white sand fine</u>	<u>60-</u>	<u>80</u>
<u>coarse sand</u>	<u>80</u>	<u>119</u>

WELL LOCATION:
sec. 15 T. 7 N. R. 10 E.
1 miles n. w of Gulfport
(distance) (direction) (nearest town)

WELL PURPOSE: office
(home, irrigation, municipal, industrial)

- WELL COMPLETION DATA:
- (1) diameter (inches) 2"
 - (2) total depth (feet) 129'
 - (3) static water level (feet) 25' below above top of ground.
 - (4) casing PVC, 119'
(material) (depth)
2" if telescope see back.
(size)
 - (5) screen 10', 119'
(length) (depth to top)
2", PVC
(size) (material)
 - (6) pump 1, 12
(HP) (yield gpm)
Electric
(type power)
 - (7) electric log No
(yes or no)
No
(organization running log)
 - (8) how well bottom plugged sand
shark

RECEIVED
APR 9 1985


DRILLERS REMARKS:

If well telescopes please sketch and show depths.

GROUND LEVEL

05 - 0
06 - 0
08 - 0
11 - 0

012-110
012-110
012-110
012-110

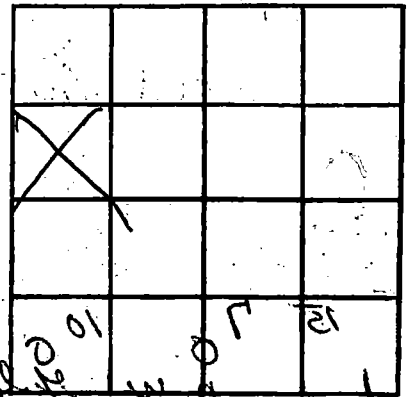

SECTION 15

Please indicate well location X.

ADDITIONAL INFORMATION

If more than one screen, show locations of each on sketch.