

MISSISSIPPI DEPARTMENT OF NATURAL RESOURCES

Bureau of Land and Water Resources

Southport Mall

P.O. Box 10631

Jackson, Mississippi 39209

WATER WELL DRILLERS LOG
COASTAL DRILLING & SERVICE CO.

HARRISON
M 2445
3/12/85

3/12/85
date well completed

RT. 11, BOX 91

firm name

Harrison
county well located

BILOXI, MS 39532

LANDOWNER: Mrs. Odell
RT. 11 BOX 91
Biloxi, MS
(mailing address)

description of formations encountered

from to

WELL LOCATION: 7
sec. 2 T. 6 N. R. 10 E. S. 5 W.
Woolmarket
(distance) miles (direction) of (nearest town)

| | | |
|-----------------|-----|-----|
| top soil | 1 | 3 |
| sea sand | 3 | 15 |
| red clay | 15 | 130 |
| hard blue clay | 130 | 240 |
| fine water sand | 240 | 250 |
| hard water sand | 250 | 260 |

WELL PURPOSE: none
(home, irrigation, municipal, industrial)


WELL COMPLETION DATA:

- (1) diameter (inches) 2"
- (2) total depth (feet) 260
- (3) static water level (feet) 10 below top of ground.
- (4) casing PVC 250 (material) (depth)
- (size) if telescope see back.
- (5) screen 10 250 (length) (depth to top)
- (size) (material) PVC
- (6) pump 1 10 (HP) (yield gpm)
- (type power) E/C
- (7) electric log NO (yes or no)

(organization running log)

- (8) how well bottom plugged 2" DRK wash water.

DRILLERS REMARKS: 19-8

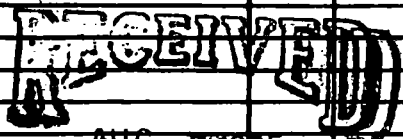


MAR 27 1985

Department of Natural Resources
Bureau of Land and Water Resources

If well telescopes please sketch and show depths.

GROUND LEVEL

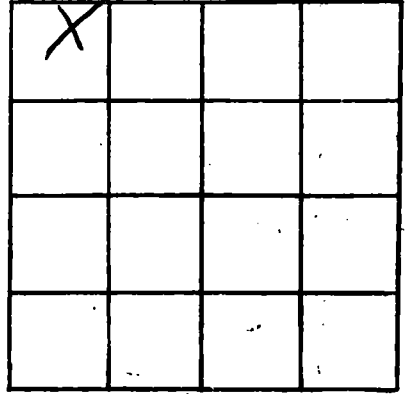

SECTION _____

Please indicate well location X.

ADDITIONAL INFORMATION

If more than one screen,
show locations of each on sketch.