

MISSISSIPPI DEPARTMENT OF NATURAL RESOURCES

Bureau of Land and Water Resources

Southport Mall

P.O. Box 10631

Jackson, Mississippi 39209

WATER WELL DRILLERS LOG
 COASTAL DRILLING & SERVICE CO.

HARRISON
 M 2446
 3/14/85

3/14/85 19 81 RT 11, BOX 81 Harrison
 date well completed firm name county well located
Biloxi, MS 39532

LANDOWNER: Shemon Electric
1340 Backward
Biloxi, MS
 (mailing address)

WELL LOCATION:
 sec 25 T 2 N R 10 E
 S W
Biloxi miles (distance) of (direction) of (nearest town)

WELL PURPOSE: home
 (home, irrigation, municipal, industrial)

WELL COMPLETION DATA:
 (1) diameter (inches) 4" x 2"
 (2) total depth (feet) 720
 (3) static water level (feet) 15 below above top of ground.
 (4) casing PVC, 205'
 (material) (depth)
 (size) If telescope see back.
 (5) screen 15, 205
 (length) (depth to top)
2" (size) PVC (material)
 (6) pump 2 18
 (HP) (yield gpm)
E/C
 (type power)
 (7) electric log NO
 (yes or no)
 (organization running log)
 (8) how well bottom plugged 2" back
washed 1978

description of formations encountered	from to	
top soil	1	5
segar sand	5	25
red clay	25	180
sift blue clay	180	330
fine water sand	330	350
hard blue clay	350	490
fine water sand	490	540
red clay	540	630
hard blue clay	630	700
fine water sand	700	710
pool water sand	710	720

RECEIVED
 AUG 27 1985

DRILLERS REMARKS:

Department of Natural Resources
 Bureau of Land and Water Resources

If well telescopes please sketch and show depths.


GROUND LEVEL

200' 4" PVC casing

520' 2" PVC casing

15' 2" PVC screen

2" backwash valve

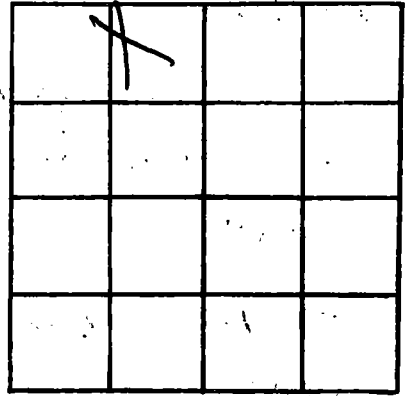

SECTION _____

Please indicate well location X.

ADDITIONAL INFORMATION

If more than one screen, show locations of each on sketch.