

MISSISSIPPI DEPARTMENT OF NATURAL RESOURCES

Bureau of Land and Water Resources

Southport Mall

P.O. Box 10631

Jackson, Mississippi 39209

WATER WELL DRILLERS LOG

HARRISON  
M 2448  
3/14/85

COASTAL DRILLING & SERVICE CO.

RT. 11, BOX 81 name

Harrison  
county well located

3/14/85  
date well completed

LANDOWNER: Ann Oubre 39137  
2041 Junshine Rd.  
Beloxi, MS  
(mailing address)

WELL LOCATION:  
sec. 31 T 2 N R 10 E  
S W  
Beloxi miles \_\_\_\_\_ of \_\_\_\_\_  
(distance) (direction) (nearest town)

WELL PURPOSE: Home  
(home, irrigation, municipal, industrial)

WELL COMPLETION DATA:

(1) diameter (inches) 2"

(2) total depth (feet) 500

(3) static water level (feet) 10 below above top of ground.

(4) casing PVC, 490 (material) (depth)  
(size) If telescope see back.

(5) screen 10, 490 (length) (depth to top)  
2" PVC (size) (material)

(6) pump 1, 11 (HP) (yield gpm)  
E/C (type power)

(7) electric log NO (yes or no)  
(organization running log)

(8) how well bottom plugged 2" back wash 190

description of formations encountered	from to	
top soil	1	3
seifer sand	3	10
red clay	10	190
silty blue clay	190	340
hard blue clay	340	480
fine water sand	480	490
coarse water sand	490	500


RECEIVED  
MAR 27 1985

Department of Natural Resources  
Bureau of Land and Water Resources

DRILLERS REMARKS:

If well telescopes please sketch and show depths.

GROUND LEVEL

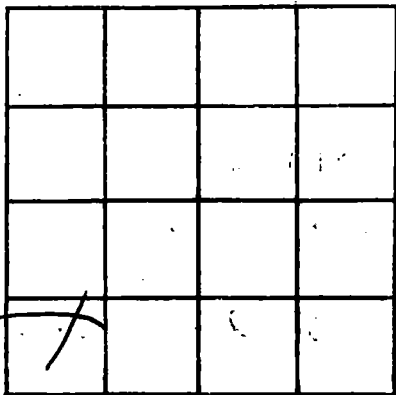

SECTION \_\_\_\_\_

Please indicate well location X.

ADDITIONAL INFORMATION

Lined area for additional information.

If more than one screen, show locations of each on sketch.