

MISSISSIPPI DEPARTMENT OF NATURAL RESOURCES

Bureau of Land and Water Resources

Southport Mall

P.O. Box 10631

Jackson, Mississippi 39209

WATER WELL DRILLERS LOG
COASTAL DRILLING & SERVICE CO.

HARRISON
M 2449
3/20/85

3/20/85 19 RT 11, BOX 81 Harrison
date well completed firm name county well located

LANDOWNER: Donald Creed
woolmarket rd
Biloxi, MS
(mailing address)

WELL LOCATION:
sec. 2 T. 6 N. R. 9 E. S. 10 W.
woolmarket
(distance) (direction) (nearest town)

WELL PURPOSE: home
(home, irrigation, municipal, industrial)

- WELL COMPLETION DATA:
- (1) diameter (inches) 2"
 - (2) total depth (feet) 300
 - (3) static water level (feet) 10 below top of ground.
 - (4) casing PVC, 290, (material) (depth)
(size) if telescope see back.
 - (5) screen 10, 290 (length) (depth to top)
2", PVC (size) (material)
 - (6) pump 1, 9 (HP) (yield gpm)
FLC (type power)
 - (7) electric log NO (yes or no)
(organization running log)
 - (8) how well bottom plugged 2" back wash water 19-B

description of formations encountered	from to	
	from	to
top soil	1	5
sugar sand	5	20
red clay	20	170
hard blue clay	170	280
the water sand	280	290
good water sand	290	300


RECEIVED
AUG 27 1985

Department of Natural Resources
Bureau of Land & Water Resources

DRILLERS REMARKS:

If well telescopes please sketch and show depths.

GROUND LEVEL

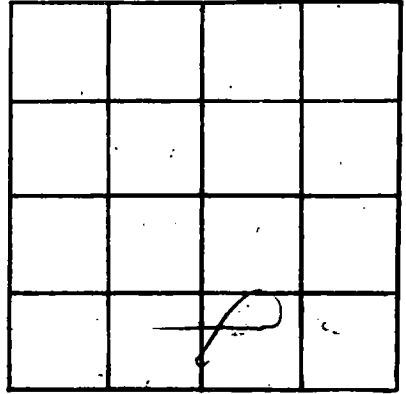

SECTION _____

Please indicate well location X.

ADDITIONAL INFORMATION

If more than one screen,
show locations of each on sketch.