

MISSISSIPPI DEPARTMENT OF NATURAL RESOURCES

Bureau of Land and Water Resources

Southport Mall

P.O. Box 10631

Jackson, Mississippi 39209

COASTAL WATER WELL DRILLERS LOG

RT. 11, BOX 81

GLOUXI, MS 39552 name

Harrison

county well located

HARRISON
M 2450
3/21/85

3/21/85
date well completed

LANDOWNER: Todd Reacock

Jim Bynard

Belgium

(mailing address)

WELL LOCATION:

sec. 3 T. 6 N. R. 10 E. S. 5 W.

Woodmont

(distance) miles (direction) of (nearest town)

WELL PURPOSE: home

(home, irrigation, municipal, industrial)

WELL COMPLETION DATA:

- (1) diameter (inches) 2"
- (2) total depth (feet) 630
- (3) static water level (feet) 10 below above top of ground.

- (4) casing PVC 620
(material) (depth)
(size) if telescope see back.

- (5) screen 10 620
(length) (depth to top)
2" PVC
(size) (material)

- (6) pump 1 1/2 15
(HP) (yield gpm)
FLC
(type power)

- (7) electric log No
(yes or no)

(organization running log)

- (8) how well bottom plugged 2" back wash valve 19-8

DRILLERS REMARKS:

description of formations encountered

from to


red clay	1	3
sugar sand	3	15
red clay	15	170
fine water sand	170	200
light blue clay	200	320
hard blue clay	320	450
fine water sand	450	480
red clay	480	600
fine water sand	600	620
good water sand	620	630

RECEIVED
AUG 27 1985

Department of Natural Resources
BUREAU OF LAND AND WATER RESOURCES

If well telescopes please sketch and show depths.

GROUND LEVEL

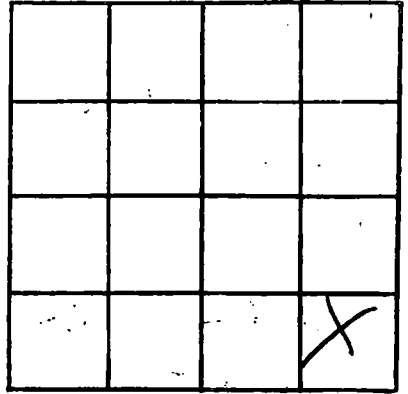

SECTION _____

Please indicate well location X.

ADDITIONAL INFORMATION

If more than one screen,
show locations of each on sketch.