

MISSISSIPPI DEPARTMENT OF NATURAL RESOURCES

Bureau of Land and Water Resources

Southport Mall

P.O. Box 10631

Jackson, Mississippi 39209

WATER WELL DRILLERS LOG

COASTAL DRILLING & SERVICE CO.

HARRISON
M 2454

4/8/85

date well completed

RT. 11, BOX 81

firm name

Harrison

county well located

BILOXI, MS 39532

LANDOWNER: John Handley

description of formations encountered

from

to

Otis Acru

top soil

1

10

Biloxi

segar sand

10

20

(mailing address)

red clay

30

190

WELL LOCATION:

Soft blue clay

190

295

sec. 22 T. 9 N. R. 9 E. S. W.

hard blue clay

295

460

fine coated sand

400

470

lapid water sand

470

480

Biloxi miles of of (distance) (direction) (nearest town)

WELL PURPOSE: home (home, irrigation, municipal, industrial)

WELL COMPLETION DATA:

(1) diameter (inches) 2"

(2) total depth (feet) 480

(3) static water level (feet) 10 below top of ground.

(4) casing PVC, 470 (material), (depth)

(size) if telescope see back.

(5) screen 10, 470 (length), (depth to top)

2" PVC (size), (material)

(6) pump 1, 11 (HP), (yield gpm)


ELC (type power)

(7) electric log NO (yes or no)

(organization running log)

(8) how well bottom plugged 2" back wash valve 19-3

DRILLERS REMARKS:

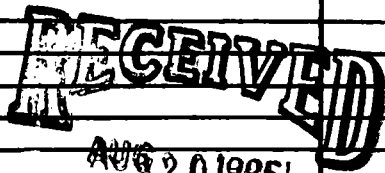

Department of Natural Resources
Bureau of Land & Water Resources

If well telescopes please sketch and show depths.

GROUND LEVEL

X			

SECTION _____

Please indicate well location X.

ADDITIONAL INFORMATION

If more than one screen, show locations of each on sketch.