

MISSISSIPPI DEPARTMENT OF NATURAL RESOURCES

Bureau of Land and Water Resources

Southport Mall

P.O. Box 10631

Jackson, Mississippi 39209

COASTAL DRILLING & SERVICE CO. DRILLERS LOG

RT. 11, BOX 81

BILOXI, MS 39538

Harrison

county well located

HARRISON
M 2455

4/18/85
date well completed

LANDOWNER: Chris Martin
Otis Acres
Biloxi, MS
(mailing address)

description of formations encountered	from	to
top soil	1	10
segar sand	10	20
red clay	20	190
soft blue clay	190	295
hard blue clay	295	460
fine water sand	460	470
lapid water sand	470	480

WELL LOCATION:
sec 22 T 2 N S R 9 E W
Biloxi miles _____ of _____
(distance) (direction) (nearest town)

WELL PURPOSE: home
(home, irrigation, municipal, industrial)

- WELL COMPLETION DATA:
- (1) diameter (inches) 2"
 - (2) total depth (feet) 480
 - (3) static water level (feet) 10 below/above top of ground.
 - (4) casing PVC, 470,
(material) (depth)
(size) If telescope see back.
 - (5) screen 10, 470
(length) (depth to top)
2", PVC
(size) (material)
 - (6) pump 1, 9
(HP) (yield gpm)
ELC
(type power)
 - (7) electric log NO
(yes or no)
(organization running log)
 - (8) how well bottom plugged 2" back wash valve 19-B


RECEIVED
AUG 20 1985

Department of Natural Resources
Bureau of Land & Water Resources

DRILLERS REMARKS:

If well telescopes please sketch and show depths.

GROUND LEVEL

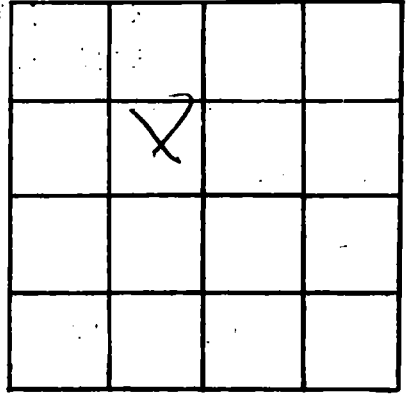

SECTION _____

Please indicate well location X.

ADDITIONAL INFORMATION

Lined area for additional information.

If more than one screen, show locations of each on sketch.