

MISSISSIPPI DEPARTMENT OF NATURAL RESOURCES

Bureau of Land and Water Resources

Southport Mall

P.O. Box 10631

Jackson, Mississippi 39209

COASTAL DRILLWATERWELL DRILLERS LOG

RT. 11, BOX 81

ENOXI, MS 39532

Harrison
county well located

HARRISON
M 2457
4/27/85

4/27/85
date well completed

LANDOWNER: McGuire Home

Wilson Edge Ave
Buloxi, ms
(mailing address)

WELL LOCATION:

sec. 35 T. 2-N S R. 10-E W

0.10 miles of (distance) (direction) of (nearest town)

WELL PURPOSE: home
(home, irrigation, municipal, industrial)

WELL COMPLETION DATA:

- (1) diameter (inches) 3"
- (2) total depth (feet) 480
- (3) static water level (feet) 10 below/above top of ground.
- (4) casing pvc, 470, (material) (depth)

 If telescope see back. (size)

- (5) screen 10, 470 (length) (depth to top)

2", pvc (size) (material)

- (6) pump 1, 10 (HP) (yield gpm)

etc (type power)

- (7) electric log NO (yes or no)

(organization running log)

- (8) how well bottom plugged 2" back wash valve 19-B

DRILLERS REMARKS:


description of formations encountered	from	to
top soil	1	3
sugar sand	3	24
red clay	24	195
hard blue clay	195	280
soft blue clay	280	450
fine water sand	450	470
coarse water sand	470	480

RECEIVED
AUG 27 1985

Department of Natural Resources
Bureau of Land & Water Resources

If well telescopes please sketch and show depths.

GROUND LEVEL

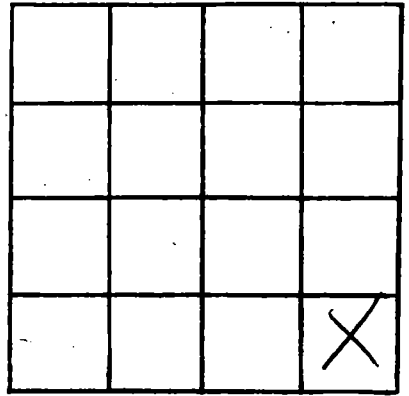

SECTION _____

Please indicate well location X.

ADDITIONAL INFORMATION

If more than one screen,
show locations of each on sketch.