

MISSISSIPPI DEPARTMENT OF NATURAL RESOURCES

Bureau of Land and Water Resources

Southport Mall

P.O. Box 10631

Jackson, Mississippi 39209

WATER WELL DRILLERS LOG

COASTAL DRILLING & SERVICE CO.

HARRISON
M 2461
5/16/85

5/16/85 date well completed RR. 11, BOX 01 firm name Harrison county well located
Biloxi, MS 39532

LANDOWNER: JACK WARD
1595 Brownwood Rd.
Biloxi, MS
(mailing address)

WELL LOCATION:
26 T_S R 9 E
S W
Biloxi miles of (distance) (direction) (nearest town)

WELL PURPOSE: home
(home, irrigation, municipal, industrial)

WELL COMPLETION DATA:
(1) diameter (inches) 2"
(2) total depth (feet) 375
(3) static water level (feet) 10 below top of ground.
(4) casing PVC 375, (material) (depth)
(size) if telescope see back.
(5) screen 10, 375 (length) (depth to top)
2" PVC (size) (material)
(6) pump 1 (HP) 11 (yield gpm)
Etc (type power)
(7) electric log NO (yes or no)
(organization running log)
(8) how well bottom plugged 2" back washwater 19-B

description of formations encountered	from	to
top soil	1	5
silty sand	5	20
red clay	20	195
hard blue clay	195	365
fine water sand	365	375
good water sand	375	385


RECEIVED
AUG 27 1985

DRILLERS REMARKS:

Department of Natural Resources
Bureau of Land & Water Resources

If well telescopes please sketch and show depths.

GROUND LEVEL

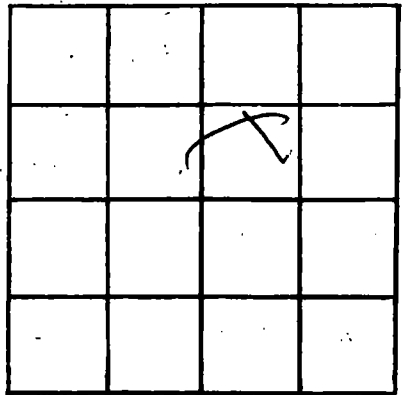

SECTION _____

Please indicate well location X.

ADDITIONAL INFORMATION

If more than one screen, show locations of each on sketch.