

MISSISSIPPI DEPARTMENT OF NATURAL RESOURCES

Bureau of Land and Water Resources

Southport Mall

P.O. Box 10631

Jackson, Mississippi 39209

COASTAL DRILLING & SERVICE CO. WATER WELL DRILLERS LOG

HARRISON
M 2463
5/25/85

5/25/85
date well completed

Rt. 11, BOX 81
BILOXI, MS 39532
firm name

Harrison
county well located

LANDOWNER: Raymond Ward
Rt. 35 Box 21
Biloxi, MS
(mailing address)

description of formations encountered	from	to
top soil	1	5
subgy sand	5	20
red clay	20	210
hard blue clay	210	340
red clay	340	480
fine white sand	480	490
spod water sand	490	500

WELL LOCATION:
sec. 3 T. 62 N. R. 10 E. S. 1
Woodman miles of W of W
(distance) (direction) (nearest town)

WELL PURPOSE: home
(home, irrigation, municipal, industrial)

WELL COMPLETION DATA:

- (1) diameter (inches) 2"
- (2) total depth (feet) 500
- (3) static water level (feet) 10 below above top of ground.
- (4) casing PVC, 490,
(material) (depth)
2" If telescope see back.
(size)
- (5) screen 10', 490
(length) (depth to top)
2", PVC
(size) (material)
- (6) pump 1, 10
(HP) (yield gpm)
1/2
(type power)
- (7) electric log NO
(yes or no)
NO
(organization running log)
- (8) how well bottom plugged 2" back
wash with 1903


DRILLERS REMARKS:

RECEIVED
AUG 27 1985

Department of Natural Resources
Bureau of Land & Water Resources

If well telescopes please sketch and show depths.

GROUND LEVEL

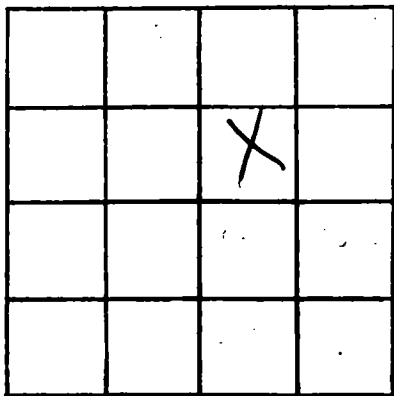

SECTION _____

Please indicate well location X.

ADDITIONAL INFORMATION

If more than one screen, show locations of each on sketch.