

MISSISSIPPI DEPARTMENT OF NATURAL RESOURCES

Bureau of Land and Water Resources

Southport Mall

P.O. Box 10631

Jackson, Mississippi 39209

WATER WELL DRILLERS LOG

COASTAL DRILLING & SERVICE CO.

HARRISON
M 2464

5/27/85
date well completed 19

RT. 11, BOX 81

Harrison
county well located

LANDOWNER: Jerry Boyd
P.O. Box 590
Biloxi, MS
(mailing address)

WELL LOCATION:
sec 27 T 7 N R 10 E
S W
Biloxi miles of
(distance) (direction) (nearest town)

WELL PURPOSE: home
(home, irrigation, municipal, industrial)

- WELL COMPLETION DATA:
- (1) diameter (inches) 2"
 - (2) total depth (feet) 330
 - (3) static water level (feet) 10 below/above top of ground.
 - (4) casing PVC, 320,
(material) (depth)
(size) if telescope see back.
 - (5) screen 10', 320
(length) (depth to top)
2", PVC
(size) (material)
 - (6) pump 1, 12
(HP) (yield gpm)
ELC
(type power)
 - (7) electric log NO
(yes or no)
(organization running log)
 - (8) how well bottom plugged 2" back
wash valve

description of formations encountered	from	to
<u>top soil</u>	<u>10</u>	<u>10</u>
<u>white sand</u>	<u>10</u>	<u>20</u>
<u>red clay</u>	<u>20</u>	<u>200</u>
<u>soft blue clay</u>	<u>200</u>	<u>300</u>
<u>fine water sand</u>	<u>300</u>	<u>310</u>
<u>good water sand</u>	<u>310</u>	<u>320</u>

DRILLERS REMARKS:


RECEIVED

DEC 20 1985

Department of Natural Resources
Bureau of Land & Water Resources

If well telescopes please sketch and show depths.

GROUND LEVEL

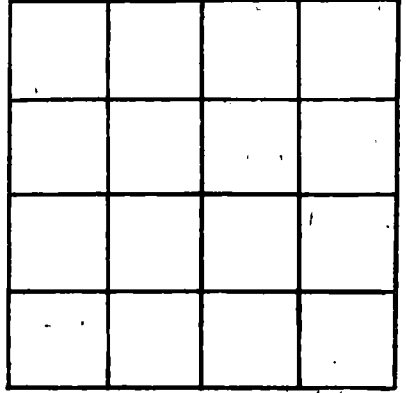

SECTION _____

Please indicate well location X.

ADDITIONAL INFORMATION

If more than one screen, show locations of each on sketch.