

**MISSISSIPPI DEPARTMENT OF NATURAL RESOURCES**  
**Bureau of Land and Water Resources**  
**Southport Mall**  
**P.O. Box 10631**  
**Jackson, Mississippi 39209**  
**WATER WELL DRILLERS LOG**

M 2466  
 Harrison  
 7-15-85

7-15-85  
 date well completed

R. J. Moore  
 firm name

HARRISON  
 county well located

LANDOWNER, ALLEN WATSON

description of formations encountered

from to

CEDA LAKE RD

Top Soil

0 10

North Biloxi  
 (mailing address)

White & Blue Clay

10 20

WELL LOCATION:

sec. 12 T 2 N R. 10 E

Blue Sand

20 50

Blue Clay

50 400

Pres. Gravel Sand 400 460

\_\_\_\_\_ miles \_\_\_\_\_ of \_\_\_\_\_  
 (distance) (direction) (nearest town)

WELL PURPOSE:  
 (home, irrigation, municipal, industrial)

WELL COMPLETION DATA:

(1) diameter (inches) 2"  
 (2) total depth (feet) 460'  
 (3) static water level (feet) 40' <sup>below</sup> <sub>above</sub> top of ground.

(4) casing Pvc, 460',  
 (material) (depth)  
 \_\_\_\_\_ If telescope see back.  
 (size)

(5) screen 10', 460'  
 (length) (depth to top)  
2", Pvc  
 (size) (material)

(6) pump 1, 8  
 (HP) (yield gpm)  
E  
 (type power)

(7) electric log \_\_\_\_\_  
 (yes or no)  
 \_\_\_\_\_  
 (organization running log)

(8) how well bottom plugged Complete


DRILLERS REMARKS:

**RECEIVED**  
 OCT 10 1985

Department of Natural Resources  
 Bureau of Land & Water Resources

If well telescopes please sketch and show depths.

GROUND LEVEL

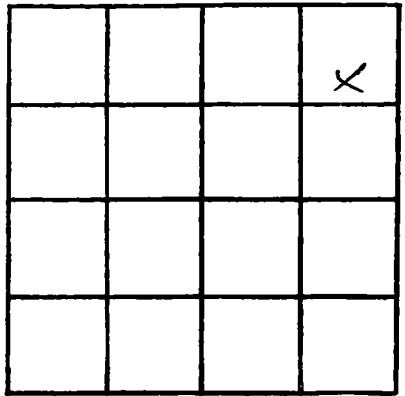

SECTION 12

Please indicate well location X.

ADDITIONAL INFORMATION

If more than one screen, show locations of each on sketch.