

MISSISSIPPI DEPARTMENT OF NATURAL RESOURCES

Bureau of Land and Water Resources

Southport Mall

P.O. Box 10631

Jackson, Mississippi 39209

WATER WELL DRILLERS LOG

Harrison  
M  
2467

Harrison

9-12-85  
 date well completed

Coast Water Well Sew. Jackson  
 firm name county well located

OWNER:  
 417 Highland Ave  
 Biloxi, Miss.  
 (mailing address) 39532

description of formations encountered from to

WELL LOCATION:  
 sec. 37 T. 7 N. R. 10 W.  
1 miles N of Biloxi  
 (distance) (direction) (nearest town)

Top Soil	0'	6'
Blue Clay	6'	76'
Gray Coarse Sand	76'	90'
Blue Clay	90'	325'
Blue Clay + oyster shell - 6" rock	325'	450'
Blue Clay	450'	488'
Gray Coarse Sand	488'	553'
Gray Coarse Sand + Gravel	553'	558'

WELL PURPOSE: home  
 (home, irrigation, municipal, industrial)

WELL COMPLETION DATA:

- (1) diameter (inches) 2"
- (2) total depth (feet) 558'
- (3) static water level (feet) 56 below top of ground.
- (4) casing PVC, 543' (material) (depth)  
2" (size) if telescope see back.
- (5) screen 10', 543' (length) (depth to top)  
2" (size) PVC (material)
- (6) pump 1 1/2 HP, 9 (HP) (yield gpm)  
Electric (type power)
- (7) electric log no (yes or no)  
 (organization running log)
- (8) how well bottom plugged Back wash valve.


RECEIVED  
 NOV - 4 1985

DRILLERS REMARKS:  
5' - 2" PVC tail pipe

Department of Natural Resources  
 Bureau of Land & Water Resources

If well telescopes please sketch and show depths.

GROUND LEVEL

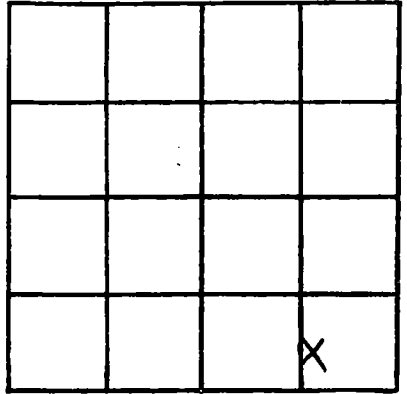

SECTION 37

Please indicate well location X.

ADDITIONAL INFORMATION

If more than one screen,  
show locations of each on sketch.