

MISSISSIPPI DEPARTMENT OF NATURAL RESOURCES
 Bureau of Land and Water Resources
 Southport Mall
 P.O. Box 10631
 Jackson, Mississippi 39209
WATER WELL DRILLERS LOG

Harrison
MA 2468

10-19 1985 Broden Pump & Well Dr. Harrison
 date well completed firm name county well located

LANDOWNER: Dr. O. Z. Culter
21514 E. Road Drive
Cullport, Miss.
 (mailing address)

WELL LOCATION:
 sec. 32 T-7 S R-10 W
4 1/2 miles E of Cullport
 (distance) (direction) (nearest town)

WELL PURPOSE: Lawn
 (home, irrigation, municipal, industrial)

WELL COMPLETION DATA:
 (1) hole diameter (inches) 4 1/2
 (2) total depth (feet) _____
 (3) static water level (feet) _____ below above top of ground.
 (4) casing (material) (depth) _____
 (size) if telescope see back.
 (5) screen (length) (depth to top) _____
 (size) (material)
 (6) pump (HP) (yield gpm) _____
 (type power) _____
 (7) electric log (yes or no) _____
 (organization running log) _____
 (8) how well bottom plugged _____

description of formations encountered	from	to
Surface	0	6
White Sand	6	30
White Clay	30	50
Brown Sand & Gravel	50	90
Blue Clay	90	210
Sand & clay breaks	210	240
Blue Clay	240	250+

8 Holes 15 FT apart
Closed Loop Heat Pump System

RECEIVED

FEB 25 1987


Department of Natural Resources
 Bureau of Land & Water Resources

2- 3/4" Ariscoll Pipes with
U Bend in each Hole
Holes Sealed with
Bentonite Mud

DRILLERS REMARKS: _____

...scopes please
sketch and show depths.

GROUND LEVEL

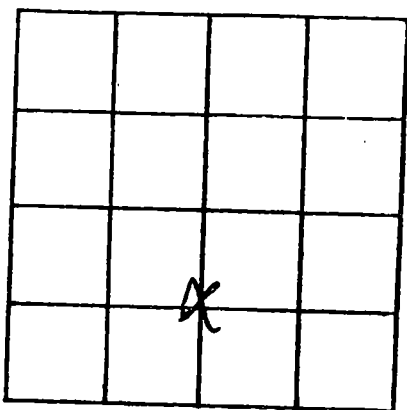

SECTION 32

Please indicate well location X.

ADDITIONAL INFORMATION

Series of horizontal lines for recording additional information.

If more than one screen,
show locations of each on sketch.