

MISSISSIPPI DEPARTMENT OF NATURAL RESOURCES

Bureau of Land and Water Resources

Southport Mall

P.O. Box 10631

Jackson, Mississippi 39209

WATER WELL DRILLERS LOG

HARRISON  
M 2469

10-22-85  
date well completed

Coast Water Well Harrison  
firm name county well located

LANDOWNER: St. Nelson  
Rt 2. Box 34D.  
Beloxi, Miss.  
(mailing address) 39132

WELL LOCATION:  
sec. 9 T. 7 S. R. 9 W.  
1/2 miles N of DIBERVILLE  
(distance) (direction) (nearest town)

WELL PURPOSE: home  
(home, irrigation, municipal, industrial)

WELL COMPLETION DATA:

(1) diameter (inches) 2"

(2) total depth (feet) 335'

(3) static water level (feet) 60 below above top of ground.

(4) casing PVC, 320'  
(material) (depth)  
2" if telescope see back.  
(size)


(5) screen 10', 320'  
(length) (depth to top)  
2", PVC  
(size) (material)

(6) pump \_\_\_\_\_  
(HP) (yield gpm)  
\_\_\_\_\_  
(type power)

(7) electric log no  
(yes or no)  
\_\_\_\_\_  
(organization running log)

(8) how well bottom plugged Backwash valve

description of formations encountered	from	to
Top soil	0'	2'
Red Clay	2'	12'
Red Coarse Sand	12'	33'
Blue Clay	33'	55'
Fine Sand	55'	90'
Med Sand	90'	107'
Blue Clay	107'	115'
Gray Coarse Sand	115'	122'
Blue Clay	122'	180'
Fine Sand	180'	190'
Blue Clay	190'	283'
Gray Coarse Sand	283'	285'
Blue Clay	285'	310'
Gray Coarse Sand	310'	330'
Blue Clay	330'	335'

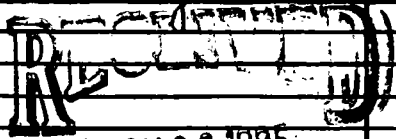


NOV 28 1985

DRILLERS REMARKS:  
5'-2" PVC tailpipe

Department of Natural Resources  
Bureau of Land & Water Resources

If well telescopes please sketch and show depths.

GROUND LEVEL

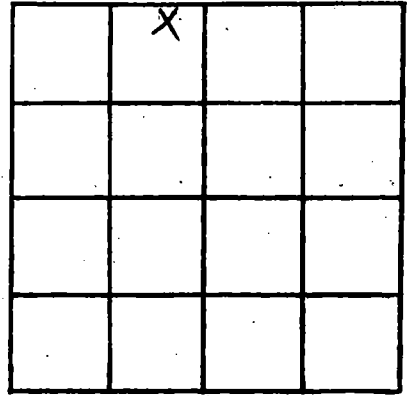

SECTION 9

Please indicate well location X.

ADDITIONAL INFORMATION

If more than one screen, show locations of each on sketch.

A handwritten mark resembling a stylized 'K' or 'G' is located in the lower right quadrant of the page, near the vertical line separating the sketch area from the additional information section.