

MISSISSIPPI DEPARTMENT OF NATURAL RESOURCES

Bureau of Land and Water Resources

Southport Mall

P.O. Box 10631

Jackson, Mississippi 39209

WATER WELL DRILLERS LOG
 COASTAL DRILLING & SERVICE CO.

Jackson
M 2474

12/18/85 19__

RT. 11, BOX 81

Jackson
 county well located

BILOXI, MS 39532

LANDOWNER: Arthur W. Fletcher

description of formations encountered

from

to

Allen Rd.

top soil

1

5

Biloxi, ms

silts and sand

5

10

(mailing address)

hard blue clay

10

190

WELL LOCATION:

red clay

190

295

sec. 11 T. 7 N. R. 10 E. S. 1 W.

sept blue clay

295

360

red clay

360

440

Biloxi miles of

fine water sand

440

450

(distance) (direction) of (nearest town)

good water sand

450

460

WELL PURPOSE: home
 (home, irrigation, municipal, industrial)

WELL COMPLETION DATA:

(1) diameter (inches) 2"

(2) total depth (feet) 460

(3) static water level (feet) 10 below above top of ground.

(4) casing DWC, 450
 (material) (depth)

(size) If telescope see back.

(5) screen 10", 450
 (length) (depth to top)

2", PVC
 (size) (material)

(6) pump 1, 10
 (HP) (yield gpm)

ELC
 (type power)

(7) electric log NO
 (yes or no)

(organization running log)

(8) how well bottom plugged 2" back wash water

RECEIVED


FEB 14 1986

Department of Natural Resources
 Bureau of Land & Water Resources

DRILLERS REMARKS:

If well telescopes please sketch and show depths.

GROUND LEVEL

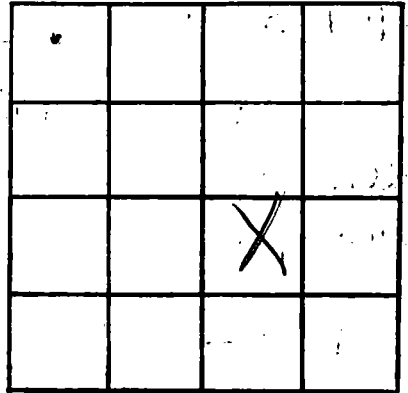

SECTION _____

Please indicate well location X.

ADDITIONAL INFORMATION

If more than one screen,
show locations of each on sketch.