

MISSISSIPPI DEPARTMENT OF NATURAL RESOURCES

Bureau of Land and Water Resources

Southport Mall

P.O. Box 10631

Jackson, Mississippi 39209

WATER WELL DRILLERS LOG

Harrison
M 2475

2/20/86 19 Lipman Well Co. Harrison
date well completed firm name county well located

LANDOWNER: James Uhl
Rt. 5, Box 239
Biloxi, MS
(mailing address)

description of formations encountered	from	to
Topsoil		1'
Clay	1'	13'
Sand	13'	31'
Clay	31'	126'
Sand	126'	132'
Clay	132'	285'
sand	285'	301'

WELL LOCATION:
sec. 12 T. 7 N. R. 10 E.
5 miles N of Biloxi
(distance) (direction) (nearest town)

WELL PURPOSE: None
(home, irrigation, municipal, industrial)

WELL COMPLETION DATA:

(1) diameter (inches) 2"

(2) total depth (feet) 301'

(3) static water level (feet) 36' below above top of ground.

(4) casing PVC, 291'
(material) (depth)
2"
(size) If telescope see back.

(5) screen 10', 291'
(length) (depth to top)
2" PVC
(size) (material)

(6) pump 1 12
(HP) (yield gpm)
electric
(type power)

(7) electric log No
(yes or no)
No
(organization running log)

(8) how well bottom plugged sand
Shark

RECEIVED


OCT 14 1986

Department of Natural Resources
Bureau of Land & Water Resources

DRILLERS REMARKS: _____

If well telescopes please sketch and show depths.

GROUND LEVEL

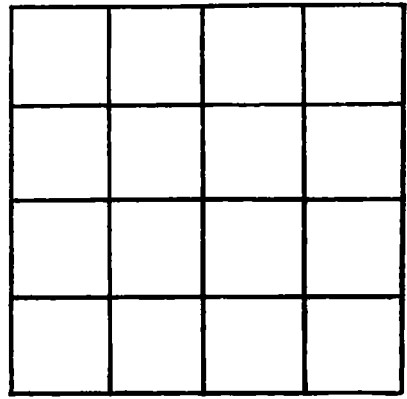

SECTION _____

Please indicate well location X.

ADDITIONAL INFORMATION

A series of horizontal lines for recording additional information, starting below the 'ADDITIONAL INFORMATION' header and extending to the bottom of the page.

If more than one screen, show locations of each on sketch.