

MISSISSIPPI DEPARTMENT OF NATURAL RESOURCES

Bureau of Land and Water Resources

Southport Mall

P.O. Box 10631

Jackson, Mississippi 39209

WATER WELL DRILLERS LOG

HARRISON
M
2481

6/30/86 19
date well completed

COASTAL DRILLING & SERVICE CO. Harrison
firm name county well located
RT 11 BOX 81

LANDOWNER: David Phyllis
Biloxi, MS

description of formations
encountered

from to

Hwy 67

top soil

1 10

Biloxi, MS
(mailing address)

red clay

10 290

WELL LOCATION:

hard blue clay

290 430

sec. 15 T 7 N R 19 E
S W

fine water sand

430 450

good water sand

450 500

miles of
(distance) (direction) (nearest town)

WELL PURPOSE: home
(home, irrigation, municipal, industrial)

WELL COMPLETION DATA:

- (1) diameter (inches) 2"
- (2) total depth (feet) 500
- (3) static water level (feet) 10 below top of ground.

(4) casing PVC, 490
(material) (depth)

(size) if telescope see back.

(5) screen 10', 490
(length) (depth to top)

2" PVC
(size) (material)

(6) pump 1 10
(HP) (yield gpm)

elc.
(type power)

(7) electric log no
(yes or no)

(organization running log)

(8) how well bottom plugged 2" back
wash valve

RECEIVED


AUG 2 10 1986

DRILLERS REMARKS:

Department of Natural Resources
Bureau of Land & Water Resources

If well telescopes please sketch and show depths.

GROUND LEVEL:

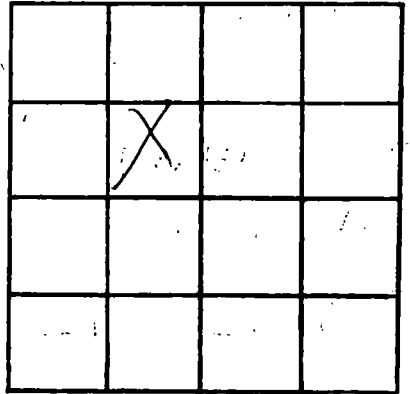

SECTION _____

Please indicate well location X.

ADDITIONAL INFORMATION

If more than one screen, show locations of each on sketch.