

MISSISSIPPI DEPARTMENT OF NATURAL RESOURCES
Bureau of Land and Water Resources

P.O. Box 10631
Jackson, Mississippi 39209
WATER WELL DRILLERS LOG

COUNTY WELL LOCATED <i>Harrison</i>
WELL NUMBER (CODED) <i>M 2486</i>
<i>5-4-87</i>
DATE WELL COMPLETED

PERMIT NUMBER <i>0-239</i>
NAME OF DRILLING FIRM <i>MC GILL PUMP & WELLS</i> <i>RT1 BOX 1643 CANAL RD</i> <i>GUPT, MS 39503</i>

NAME & MAILING ADDRESS OF LANDOWNER <i>EA Enrown (Keith White)</i>		
<i>532 Poppo Jerry</i>		
<i>Belopi, Mo.</i>		
WELL LOCATION: SEC	TOWNSHIP	RANGE
<i>5</i>	<i>7 N</i>	<i>10 E</i>
DISTANCE	DIRECTION	NEAREST TOWN
<i>2</i> Miles	<i>north</i>	<i>Gulfport</i>
OTHER LANDMARK <i>2</i>		
WELL PURPOSE: Home Irrigation, Municipal, Industrial, Fish Pond, etc. <input checked="" type="radio"/> Home		

PUMP DATA		
PUMP TYPE (Circle One): Submersible, Turbine, <input checked="" type="radio"/> Jet, Flowing Well, Other (Describe) _____		
POWER TYPE (Circle One): <input checked="" type="radio"/> Electric, Tractor, Diesel, Gasoline, Butane, Other (Describe) _____		
Pump Capacity (GPM) <i>10-15</i>	No. of Stages <i>2</i>	Setting Depth _____ FT.
PUMP TEST		
Well yielded <i>10</i> GPM with a drawdown of <i>5</i> ft. after <i>1</i> hours of pumping		

WELL DATA		
Well Depth <i>500'</i>	Casing Diameter (In.) <i>2"</i>	Casing Length (Ft.) <i>20'</i>
Type of Casing <i>PVC</i>	Hole Depth <i>500'</i>	Depth to Static Water Level <i>60'</i>
TYPE OF COMPLETION: (Circle One or More): Gravel Packed, Underreamed, Telescoped, <input checked="" type="radio"/> Natural Development, Open Hole, Other (Describe) _____		
Top of Lap Pipe or Reduction in Casing FEET <input type="checkbox"/> IF TELESCOPED OR MORE THAN ONE SCREEN: USE BACK PAGE		

LOG DATA	
TYPE OF LOG RUN (Circle One): <input checked="" type="radio"/> No Log Run <input checked="" type="radio"/> Electric, Gamma Ray, Density, Sonic, Neutron, Other (Describe) _____	
Name of Organization Running Log	

SCREEN DATA		
Diameter - Inches <i>2"</i>	Length - Feet <i>10'</i>	Slot Size - Inches <i>10000</i>
Screen Type <i>open pvc</i>	Depth to Bottom - Feet	

GEOLOGIC DATA (Office Use Only)			
Surface Elev.	Geologic Unit	Unit Thickness	Depth to Top
Subs. SWL	Date	Analysis	Aquifer Test
Driller's Remarks			

DESCRIPTION OF FORMATIONS ENCOUNTERED	FROM	TO	FORMATIONS (Continued)	FROM	TO
<i>Mud</i>	<i>0</i>	<i>10</i>			
<i>Sand</i>	<i>10</i>	<i>110</i>			
<i>mud</i>	<i>110</i>	<i>340</i>			
<i>Sand</i>	<i>340</i>	<i>350</i>			
<i>mud</i>	<i>350</i>	<i>400</i>			
<i>Sand</i>	<i>400</i>	<i>500'</i>			

RECEIVED


MAY 27 1987

Department of Natural Resources
Bureau of Land & Water Resources

IF MORE SPACE IS NEEDED, USE BACK

If well telescopes please sketch and show depths.

GROUND LEVEL

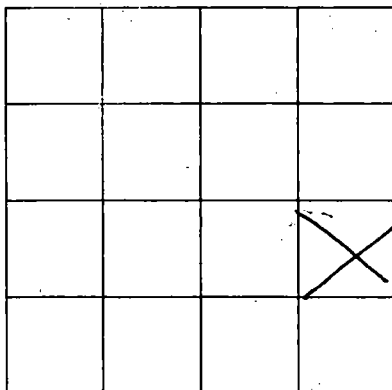

SECTION _____

Please indicate well location X.

ADDITIONAL INFORMATION

If more than one screen,
show location of each on sketch.