

**MISSISSIPPI DEPARTMENT OF NATURAL RESOURCES**  
Bureau of Land and Water Resources

P.O. Box 10631

Jackson, Mississippi 39209

**WATER WELL DRILLERS LOG**

COUNTY WELL LOCATED <b>Harrison</b>	
WELL NUMBER <b>M</b>	CODED <b>2992</b>
DATE WELL COMPLETED <b>May 4 87</b>	

PERMIT NUMBER <b>0-239</b>
NAME OF DRILLING FIRM <b>McGILL PUMP &amp; WELLS</b>
<b>RT1 BOX 1643 CANAL RD</b>
<b>GUPT, MS 39503</b>

NAME & MAILING ADDRESS OF LANDOWNER <b>Kieth White</b>		
<b>Rt. 2, Box 284C</b>		
<b>Gulfport Ms.</b>		
WELL LOCATION: SEC	TOWNSHIP	RANGE
<b>18</b>	<b>7</b>	<b>9</b>
DISTANCE	DIRECTION	NEAREST TOWN
<b>4</b> Miles	<b>North</b> of	<b>Biloxi</b>
OTHER LANDMARK		
WELL PURPOSE (Home) <input checked="" type="checkbox"/> Irrigation, Municipal, Industrial, Fish Pond, etc.		

<b>PUMP DATA</b>		
PUMP TYPE (Circle One): Submersible, Turbine, <input checked="" type="radio"/> <b>Flowing Well</b> , Other (Describe) _____		
POWER TYPE (Circle One): <input checked="" type="radio"/> <b>Electric</b> Tractor, Diesel, Gasoline, Butane, Other (Describe) _____		
Pump Capacity (GPM) <b>13</b>	No. of Stages <b>2</b>	Setting Depth <b>40'</b> FT.
PUMP TEST		
Well yielded <b>13</b> GPM with a drawdown of <b>10</b> ft. after <b>1</b> hours of pumping		

<b>WELL DATA</b>		
Well Depth <b>400'</b>	Casing Diameter (In.) <b>2"</b>	Casing Length (Ft.) <b>400'</b>
Type of Casing <b>PVC</b>	Hole Depth <b>400'</b>	Depth to Static Water Level <b>20'</b>
TYPE OF COMPLETION: (Circle One or More): Gravel Packed, Underreamed, Telescoped, <input checked="" type="checkbox"/> <b>Natural Development</b> , Open Hole, Other		
Top of Lap Pipe or Reduction in Casing		
FEET	IF TELESCOPED OR MORE THAN ONE SCREEN: USE BACK PAGE	

<b>LOG DATA</b>	
TYPE OF LOG RUN (Circle One): Electric, Gamma Ray, Density, Sonic, <input checked="" type="checkbox"/> <b>No Log Run</b> , Neutron, Other (Describe) _____	
Name of Organization Running Log	

<b>SCREEN DATA</b>		
Diameter - Inches <b>2"</b>	Length - Feet <b>10'</b>	Slot Size - Inches <b>6ths.</b>
Screen Type <b>PVC</b>	Depth to Bottom - Feet <b>400'</b>	

<b>GEOLOGIC DATA (Office Use Only)</b>			
Surface Elev.	Geologic Unit	Unit Thickness	Depth to Top
Subs. SWL	Date	Analysis	Aquifer Test

Driller's Remarks


**RECEIVED**

DESCRIPTION OF FORMATIONS ENCOUNTERED	FROM	TO
<b>Sand</b>	<b>0</b>	<b>40</b>
<b>mud</b>	<b>40</b>	<b>160</b>
<b>Sand</b>	<b>160</b>	<b>170</b>
<b>mud</b>	<b>170</b>	<b>340</b>
<b>sand</b>	<b>340</b>	<b>400</b>

FORMAL TESTS (Continued)	FORM TO
<b>JUL 24 1987</b>	
<b>Department of Natural Resources</b>	
<b>Bureau of Land &amp; Water Resources</b>	
IF MORE SPACE IS NEEDED, USE BACK	

If well telescopes please sketch and show depths.

GROUND LEVEL

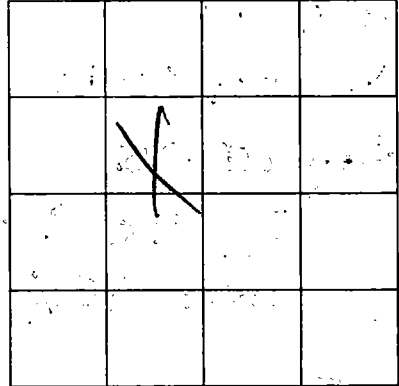

SECTION \_\_\_\_\_

Please indicate well location X.

ADDITIONAL INFORMATION

A series of horizontal lines for writing additional information.

If more than one screen, show location of each on sketch.