

MISSISSIPPI DEPARTMENT OF NATURAL RESOURCES

Bureau of Land and Water Resources

Southport Mall

P.O. Box 10631

Jackson, Mississippi 39209

WATER WELL DRILLERS LOG

HARRISON  
M 2495

9-29-87 19  
date well completed

R.V. Moche  
firm name

HARRISON  
county well located

LANDOWNER: PLEY VORDON  
7603 OAK LAWN RD  
WOOD MARKET  
BRN M S  
(mailing address)

description of formations encountered	from	to
<u>TOP SOIL &amp; CLAY</u>	<u>0</u>	<u>20</u>
<u>Blue Sand</u>	<u>20</u>	<u>60</u>
<u>Blue Clay</u>	<u>60</u>	<u>200</u>
<u>Yell Sand</u>	<u>200</u>	<u>260</u>
<u>Blue Clay</u>	<u>260</u>	<u>440</u>
<u>Med Sand</u>	<u>440</u>	<u>460</u>
<u>BRN. Sand</u>	<u>460</u>	<u>500</u>

WELL LOCATION:  
sec. 3 T. 7 N. R. 10 E.  
1 1/2 miles (distance) W (direction) of WOOD MARKET (nearest town)

WELL PURPOSE:  
(home, irrigation, municipal, industrial)

WELL COMPLETION DATA:

(1) diameter (inches) 2"

(2) total depth (feet) 500'

(3) static water level (feet) 50' <sup>below</sup> <sub>above</sub> top of ground.

(4) casing PVC (material), 500' (depth)

       (size) if telescope see back.

(5) screen 10' (length), 500' (depth to top)

2" (size), PVC (material)

(6) pump 1 (HP), 6 (yield gpm)

E (type power)

(7) electric log        (yes or no)

       (organization running log)

(8) how well bottom plugged       

DRILLERS REMARKS: 1


**RECEIVED**

NOV 04 1987

Department of Natural Resources  
Bureau of Land & Water Resources

If well telescopes please sketch and show depths.

GROUND LEVEL

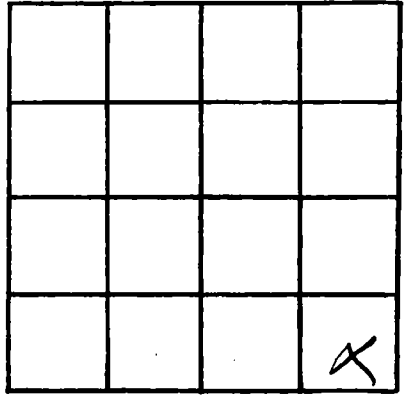

SECTION 3

Please indicate well location X.

ADDITIONAL INFORMATION

If more than one screen, show locations of each on sketch.