

MISSISSIPPI DEPARTMENT OF NATURAL RESOURCES

Bureau of Land and Water Resources

COUNTY WELL LOCATED Harrison	
WELL NUMBER M-2499	CODED
DATE WELL COMPLETED July 1-88	

PERMIT NUMBER
NAME OF DRILLING FIRM M & B Drilling Co.

P.O. Box 10631
Jackson, Mississippi 39209
WATER WELL DRILLERS LOG

NAME & MAILING ADDRESS OF LANDOWNER Ar. O.Z. Culler			
01814 E. Booth			
Halfport, Ms.			
WELL LOCATION:	SEC	TOWNSHIP	RANGE
	32	7 S	10 W
DISTANCE	DIRECTION	NEAREST TOWN	
4 1/2 Miles	E	of Halfport	
OTHER LANDMARK			
WELL PURPOSE: Home, Irrigation, Municipal, Industrial, Fish Pond, etc. Lawn & Home			

PUMP DATA		
PUMP TYPE (Circle One): <input checked="" type="radio"/> Submersible Turbine, Jet Flowing Well, Other (Describe) _____		
POWER TYPE (Circle One): <input checked="" type="radio"/> Electric Tractor, Diesel, Gasoline, Butane, Other (Describe) _____		
Pump Capacity (GPM) 50	No. of Stages	Setting Depth 120 FT.
PUMP TEST		
Well yielded _____ GPM with a drawdown of _____ ft. after _____ hours of pumping		

WELL DATA		
Well Depth 860	Casing Diameter (In.) 4"	Casing Length (Ft.) 840
Type of Casing PVC	Hole Depth 860	Depth to Static Water Level 60
TYPE OF COMPLETION: (Circle One or More): <input checked="" type="checkbox"/> Natural Development <input type="checkbox"/> Gravel Packed <input type="checkbox"/> Underreamed, <input type="checkbox"/> Telescoped, <input type="checkbox"/> Open Hole, <input type="checkbox"/> Other		
Top of Lap Pipe or Reduction in Casing		
FEET	IF TELESKOPED OR MORE THAN ONE SCREEN: USE BACK PAGE	

LOG DATA	
TYPE OF LOG RUN (Circle One): <input checked="" type="radio"/> No Log Run <input type="radio"/> Electric, <input type="radio"/> Gamma Ray, <input type="radio"/> Sonic, <input type="radio"/> Neutron, Other (Describe) _____	
Name of Organization Running Log	

GEOLOGIC DATA (Office Use Only)			
Surface Elev.	Geologic Unit	Unit Thickness	Depth to Top
Subs. SWL	Date	Analysis	Aquifer Test

SCREEN DATA		
Diameter - Inches 4"	Length - Feet 20	Slot Size - Inches .010
Screen Type PVC Wrapped	Depth to Bottom - Feet 860	


RECEIVED
DEC 25 1988
Department of Natural Resources
Bureau of Land & Water Resources

Replaces 2 - 4" holes - 4 1/2" to 70 ft Wells

DESCRIPTION OF FORMATIONS ENCOUNTERED	FROM	TO	FORMATIONS (Continued)	FROM	TO
Silt. Sand	0	4			
White Sand	4	30			
White Clay	30	50			
Brown Silt & Gravel	50	90			
Blue Clay	90	220			
Sand	220	230			
Sand & Clay Layer	230	520			
Soft Green Clay	520	600			
Blue Clay	600	820			
Grey Sand	820	860	+		
IF MORE SPACE IS NEEDED, USE BACK					

If well telescopes please sketch and show depths.

GROUND LEVEL

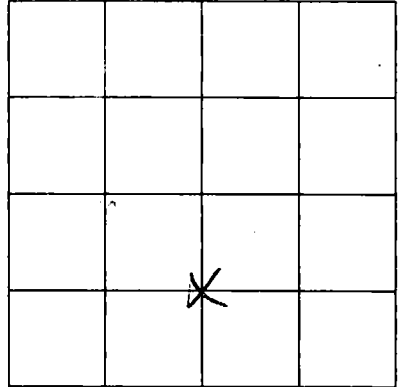

SECTION 32

Please indicate well location X.

ADDITIONAL INFORMATION

If more than one screen, show location of each on sketch.