

MISSISSIPPI DEPARTMENT OF NATURAL RESOURCES

Bureau of Land and Water Resources

P.O. Box 10631
Jackson, Mississippi 39209
WATER WELL DRILLERS LOG

COUNTY WELL LOCATED <i>Harrison</i>	
WELL NUMBER <i>M 2509</i>	CODED
DATE WELL COMPLETED <i>5/2/91</i>	

PERMIT NUMBER <i>0239</i>
NAME OF DRILLING FIRM <i>McBitt Pump & Well</i>

NAME & MAILING ADDRESS OF LANDOWNER <i>Jane Deluission</i>			
<i>143 Oakwood dr.</i>			
<i>Shuffport Ms.</i>			
WELL LOCATION	SEC	TOWNSHIP	RANGE
	<i>29</i>	<i>7 N</i>	<i>10 E</i>
DISTANCE	DIRECTION	NEAREST TOWN	
<i>2</i> Miles	<i>East</i> of	<i>Get</i>	
OTHER LANDMARK <i>Pass Rd</i>			
WELL PURPOSE: Home, <u>Irrigation</u> , Municipal, Industrial, Fish Pond, etc.			

PUMP DATA		
PUMP TYPE (Circle One): <u>Submersible</u> Turbine, Jet Flowing Well, Other (Describe) _____		
POWER TYPE (Circle One): <u>Electric</u> Tractor, Diesel, Gasoline, Butane, Other (Describe) _____ H/P _____		
Pump Capacity (GPM) <i>18</i>	No. of Stages <i>18</i>	Setting Depth <i>60'</i> FT.
PUMP TEST		
Well yielded <i>25</i> GPM with a drawdown of <i>20</i> ft. after <i>1</i> hours of pumping		

WELL DATA		
Well Depth <i>150</i>	Casing Diameter (In.) <i>4"</i>	Casing Length (Ft.) <i>20</i>
Type of Casing <i>PVC</i>	Hole Depth <i>150</i>	Depth to Static Water Level <i>20</i>
TYPE OF COMPLETION: (Circle One or More): Gravel Packed, Underreamed, Telescoped, <u>Natural Development</u> , Open Hole, Other (Describe) _____		
Top of Lap Pipe or Reduction in Casing FEET IF TELESCOPED OR MORE THAN ONE SCREEN: USE BACK PAGE		


LOG DATA	
TYPE OF LOG RUN (Circle One): Electric, Gamma Ray, Density, . Sonic, Neutron, Other (Describe) _____ <u>No Log Run</u>	
Name of Organization Running Log _____	

SCREEN DATA		
Diameter - Inches <i>4"</i>	Length - Feet <i>20'</i>	Slot Size - Inches <i>.00016</i>
Screen Type <i>PVC</i>	Depth to Bottom - Feet <i>150</i>	

GEOLOGIC DATA (Office Use Only)			
Surface Elev.	Geologic Unit	Unit Thickness	Depth to Top
Subs. SWL	Date	Analysis	Aquifer Test


Driller's Remarks

DESCRIPTION OF FORMATIONS ENCOUNTERED	FROM	TO
<i>Sand</i>	<i>0</i>	<i>30</i>
<i>mud</i>	<i>30</i>	<i>120</i>
<i>Sand</i>	<i>120</i>	<i>150</i>

FORMATIONS (Continued)	FROM	TO
 SEP 23 1991 Dept. of Environmental Quality Bureau of Land & Water Resources		
IF MORE SPACE IS NEEDED, USE BACK		

If well telescopes please sketch and show depths.

GROUND LEVEL

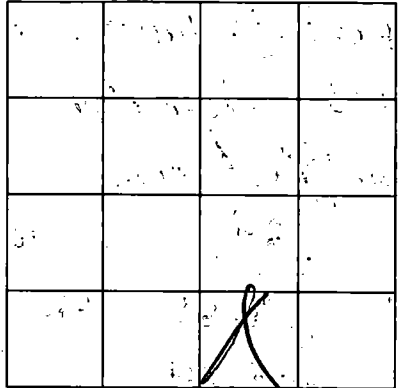

SECTION _____

Please indicate well location X.

ADDITIONAL INFORMATION

Lined area for additional information.

If more than one screen, show location of each on sketch.