

MISSISSIPPI DEPARTMENT OF NATURAL RESOURCES

Bureau of Land and Water Resources

COUNTY WELL LOCATED <i>Harrison</i>	
WELL NUMBER <i>M 2574</i>	CODED
DATE WELL COMPLETED <i>8-3-88</i>	

PERMIT NUMBER
NAME OF DRILLER/OWNER Coastal Drilling & Service Co. 8456 Woolmarket Biloxi Road Biloxi, Mississippi 39532

P.O. Box 10631
Jackson, Mississippi 39209
WATER WELL DRILLERS LOG

NAME & MAILING ADDRESS OF LANDOWNER <i>Mr Seymour</i> <i>Bittles Street</i> <i>Biloxi, Ms. 39532</i>		
WELL LOCATION: SEC	TOWNSHIP	RANGE
<i>Harrison 21</i>	<i>7</i>	<i>9</i>
DISTANCE _____ Miles _____ of <i>D'Iberville</i>		
OTHER LANDMARK <i>D'Iberville</i>		
WELL PURPOSE: Home Irrigation, Municipal, Industrial, Fish Pond, etc. <i>Home</i>		

PUMP DATA		
PUMP TYPE (Circle One): Submersible, Turbine, <input checked="" type="radio"/> Jet, Flowing Well, Other (Describe) _____		
POWER TYPE (Circle One): <input checked="" type="radio"/> Electric, Tractor, Diesel, Gasoline, Butane, Other (Describe) _____		
Pump Capacity (GPM) <i>10</i>	No. of Stages	Setting Depth FT.
PUMP TEST		
Well yielded _____ GPM with a drawdown of _____ ft. after _____ hours of pumping		

WELL DATA		
Well Depth <i>278'</i>	Casing Diameter (In.) <i>2"</i>	Casing Length (Ft.) <i>270'</i>
Type of Casing <i>PVC</i>	Hole Depth <i>278</i>	Depth to Static Water Level <i>45'</i>
TYPE OF COMPLETION: (Circle One or More): <input checked="" type="checkbox"/> Gravel Packed, <input type="checkbox"/> Underreamed, <input type="checkbox"/> Telescoped, <input checked="" type="checkbox"/> Natural Development, <input type="checkbox"/> Open Hole, <input type="checkbox"/> Other (Describe) _____		
Top of Lap Pipe or Reduction in Casing FEET _____ IF TELESCOPED OR MORE THAN ONE SCREEN: USE BACK PAGE		

LOG DATA	
TYPE OF LOG RUN (Circle One): No Log Run, Electric, Gamma Ray, Density, Sonic, Neutron, Other (Describe) _____	
Name of Organization Running Log	

SCREEN DATA		
Diameter - Inches <i>2"</i>	Length - Feet <i>10'</i>	Slot Size - Inches <i>.008</i>
Screen Type <i>PVC</i>	Depth to Bottom - Feet <i>278</i>	


GEOLOGIC DATA (Office Use Only)			
Surface Elev.	Geologic Unit	Unit Thickness	Depth to Top
Subs. SWL	Date	Analysis	Aquifer Test
Driller's Remarks <i>Did not install a new pump</i>			

DESCRIPTION OF FORMATIONS ENCOUNTERED	FROM	TO
<i>top soil</i>	<i>1'</i>	<i>3'</i>
<i>Red sand</i>	<i>3'</i>	<i>10'</i>
<i>white sand</i>	<i>10'</i>	<i>25'</i>
<i>soft blue clay</i>	<i>25'</i>	<i>200'</i>
<i>fine water sand</i>	<i>200'</i>	<i>270'</i>
<i>coarse water sand</i>	<i>270'</i>	<i>278'</i>

FORMATIONS (Continued)	FROM	TO
RECEIVED		
FEB 10 1992		
Dept. of Environmental Quality Bureau of Land & Water Resources		
IF MORE SPACE IS NEEDED, USE BACK		

If well telescopes please sketch and show depths.

GROUND LEVEL

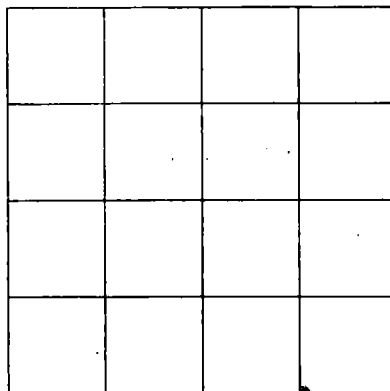

SECTION _____

Please indicate well location X.

ADDITIONAL INFORMATION

If more than one screen,
show location of each on sketch.