

HAR.

MISSISSIPPI BOARD OF WATER COMMISSIONERS

M

WATER WELL DRILLERS LOG

6-63 2550

Date: June, 1963, Driller: L. S. Garland County: Jackson

(Name)

(1) Owner of Land:	Description & Color of Materials Sand, Clay, Red Clay, Shell, etc.	Thick- ness Feet	Depth Feet
C. W. Crissman (Name)	1 14' 8" 7' M.		
Bellefontaine Beach (Address)	2 S. & M. S.		
(2) Location: 1/4, 1/4, Sec. T 19 R 1	3 5' M. 10' S. 6' M.		
8 miles SW of O.S. (distance) (direction) (Nearest Town)	4 S & M S.		
(3) Topography: (Hilly) (Flat) (Level)	5 mud		
(4) Purpose of Well: Dom. (Domestic Irrigation Municipal, Industrial, Other)	6 5' M. 16' S.		
	7 mix.		
	8 mud		
	9 "		
	10 10' M. 11' S.		
	11 mix.		
	12 Shale M & S S		
	13 mix.		
	14 S. S. & M.		
	15 mix.		
	16 mud		
	17 "		
	18 "		
	19 " & shale		
	20 " & S		
	21 Fine sand		
	22 "		
	23 11' mix. 10' sand		
	24 sand		


Information upon completion of well:

- (1) Diameter 2 inches.
- (2) Total Depth 504 feet.
- (3) Water Level Floored feet below top of ground.
- (4) Cased to _____, Size _____
- (5) Screen: Size .08, Length 10
- (6) Were any formations sealed against pollution?
_____ yes, _____ no.

If YES depth of formation _____

Why _____

Drillers Remarks: _____

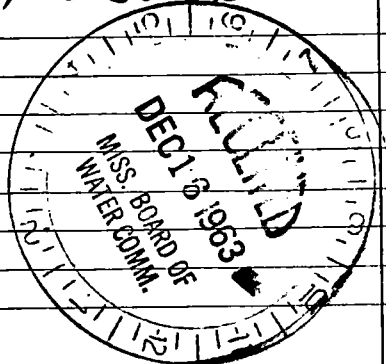

(Use Back Side)

Well No.

