

MISSISSIPPI DEPARTMENT OF NATURAL RESOURCES

Bureau of Land and Water Resources

Southport Mall

P.O. Box 10631

Jackson, Mississippi 39209

WATER WELL DRILLERS LOG

COASTAL DRILLING & SERVICE CO.

Harrison
M 2553
6-15-84

6/15/84
date well completed

Rt. 1, Box 81

Harrison
county well located


LANDOWNER: George Noche
Oak Grove Estates
Biloxi, MS
(mailing address)

WELL LOCATION:
sec 18 T. 6 N. R. 9 E
S W
Biloxi miles of
(distance) (direction) (nearest town)

WELL PURPOSE:
(home, irrigation, municipal, industrial)

WELL COMPLETION DATA:
(1) diameter (inches) 4" x 2"
(2) total depth (feet) 320
(3) static water level (feet) 15 below top of ground.
(4) casing PVC, 305 (material) (depth) 4" x 2" (size) if telescope see back.
(5) screen 15' (length) 305 (depth to top) 2" (size) PVC (material)
(6) pump 1 (HP) 88 (yield gpm) ETC (type power)
(7) electric log No (yes or no)
(organization running log)
(8) how well bottom plugged 2" back-wood valve 19-B

Description of formations encountered	from	to
top soil	1	5
red clay	5	25
sugar sand	25	50
soft blue clay	50	180
hard blue clay	180	300
fine water sand	300	310
good water sand	310	320

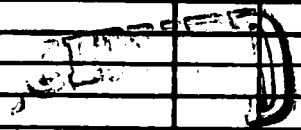

JUN 22 1985

18-...
4800...
National Resources

DRILLERS REMARKS:

If well telescopes please sketch and show depths.


GROUND LEVEL

160' 4" pvc casing

160 2" pvc casing

15' 2" pvc screen

2" back wash valve

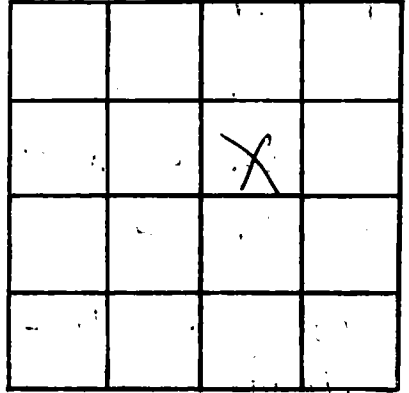

SECTION _____

Please indicate well location X.

ADDITIONAL INFORMATION

If more than one screen, show locations of each on sketch.