

MISSISSIPPI DEPARTMENT OF ENVIRONMENTAL QUALITY

Office of Land and Water Resources

P. O. Box 10631
Jackson, MS 39289-0631
WATER WELL DRILLERS LOG

| | |
|---|-------|
| COUNTY, WELL LOCATED <i>Harrison</i> | |
| WELL NUMBER <i>M 2570</i> | CODED |
| DATE WELL COMPLETED <i>3-12-97</i> | |

| |
|--|
| PERMIT NUMBER |
| NAME OF DRILLING FIRM <i>Coast Water Well Service</i> |

| | | | |
|--|--------------|------------------|------------|
| NAME & MAILING ADDRESS OF LANDOWNER <i>Alan Kovocovich</i> | | | |
| <i>West Bay Rd.</i> | | | |
| <i>Biloxi, Ms</i> | | | |
| WELL LOCATION | SEC | TOWNSHIP | RANGE |
| | <i>8</i> | <i>7</i> | <i>9 E</i> |
| DISTANCE | DIRECTION | NEAREST TOWN | |
| <i>3</i> Miles | <i>NORTH</i> | of <i>Biloxi</i> | |
| OTHER LANDMARK | | | |
| WELL PURPOSE <input checked="" type="radio"/> Home, <input type="radio"/> Irrigation, <input type="radio"/> Municipal, <input type="radio"/> Industrial, <input type="radio"/> Fish Pond, etc. | | | |

| | | |
|--|---------------------------|---------------------------------|
| PUMP DATA | | |
| PUMP TYPE (Circle One): Submersible, Turbine, <input checked="" type="radio"/> Jet, <input type="radio"/> Flowing Well, Other (Describe) _____ | | |
| POWER TYPE (Circle One): <input checked="" type="radio"/> Electric, <input type="radio"/> Tractor, <input type="radio"/> Diesel, <input type="radio"/> Gasoline, <input type="radio"/> Butane, Other (Describe) _____ H/P <i>1</i> | | |
| Pump Capacity (GPM) <i>8</i> | No. of Stages <i>2</i> | Setting Depth FT. |
| PUMP TEST | | |
| Well yielded _____ GPM with a drawdown of _____ ft. after _____ hours of pumping | | |

| | | |
|------------------------------|-----------------------------------|---|
| WELL DATA | | |
| Well Depth <i>335'</i> | Casing Diameter (In) <i>2"</i> | Casing Length (Ft.) <i>325'</i> |
| Type of Casing <i>PVC</i> | Hole Depth <i>335'</i> | Depth to Static Water Level <i>60'</i> |

| | |
|--|--|
| LOG DATA | |
| TYPE OF LOG RUN (Circle One): Electric, Gamma Ray, Density, Sonic, Neutron, Other (Describe) _____ <input checked="" type="radio"/> No Log Run | |
| Name of Organization Running Log | |

TYPE OF COMPLETION: (Circle One or More):
 Gravel Packed, Underreamed, Telescoped,
 Natural Development, Open Hole, Other
 (Describe) _____

| | | | |
|--|---------------|----------------|--------------|
| GEOLOGIC DATA (Office Use Only) | | | |
| Surface Elev. | Geologic Unit | Unit Thickness | Depth to Top |
| Subs. SWL | Date | Analysis | Aquifer Test |

WELL GROUTED TO A DEPTH OF *2* FEET
 Type Grout (circle one): Cement, Bentonite, or Mix

| | | |
|--------------------------------|---------------------------------------|-----------------------------------|
| SCREEN DATA | | |
| Diameter - Inches <i>2"</i> | Length - Feet <i>10'</i> | Slot Size - Inches <i>.008</i> |
| Screen Type <i>PVC</i> | Depth to Bottom - Feet <i>335'</i> | |

| | |
|--|--|
| Driller's Remarks | |
| Top of Lap Pipe or Reduction in Casing | |
| FEET | IF TELESCOPED OR MORE THAN ONE SCREEN: USE BACK PAGE |

| DESCRIPTION OF FORMATIONS ENCOUNTERED | FROM | TO |
|---------------------------------------|------------|------------|
| <i>Top Soil</i> | <i>0</i> | <i>2</i> |
| <i>Brown Clay</i> | <i>2</i> | <i>25</i> |
| <i>White Coarse sand</i> | <i>25</i> | <i>70</i> |
| <i>Blue Clay Shale sand</i> | <i>70</i> | <i>316</i> |
| <i>Gray Coarse sand</i> | <i>316</i> | <i>335</i> |
| | | |
| | | |
| | | |
| | | |

RECEIVED


JUL 21 1997

Dept. of Environmental Quality
Office of Land & Water Resources

IF MORE SPACE IS NEEDED, USE BACK

If well telescopes please
sketch and show depths.

GROUND LEVEL

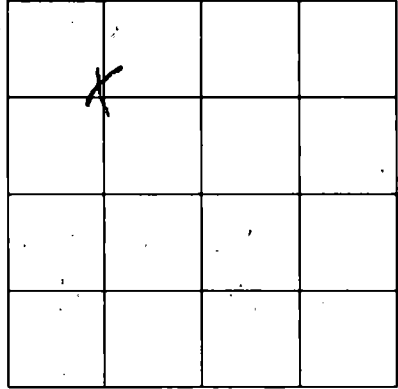

SECTION 8

Please indicate well location X.

ADDITIONAL INFORMATION

If more than one screen,
show location of each on sketch.