




If well telescopes please sketch and show depths.

GROUND LEVEL

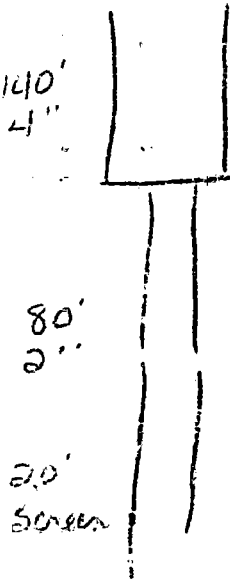

80'  
2"

2.0'  
Screen

	X		

SECTION \_\_\_\_\_

Please indicate well location X.

Pump Capacity (GPM) <u>18</u>	No. of Stages <u>10</u>	Setting Depth <u>100'</u> FT.
----------------------------------	----------------------------	----------------------------------

PUMP TEST

Well yielded 18 GPM with  
a drawdown of 10 ft.  
after 12 hours of pumping

LOG DATA

TYPE OF LOG RUN (Circle One): No Log Run  
Electric, Gamma Ray, Density, Sonic, Neutron,  
Other (Describe) \_\_\_\_\_

Name of Organization Running Log \_\_\_\_\_

GEOLOGIC DATA (Office Use Only)

Surface Elev.	Geologic Unit	Unit Thickness	Depth to Top
Subs. SWL	Date	Analysis	Aquifer Test

Driller's Remarks

If more than one screen,  
show location of each on sketch.