


If well telescopes please sketch and show depths.

GROUND LEVEL

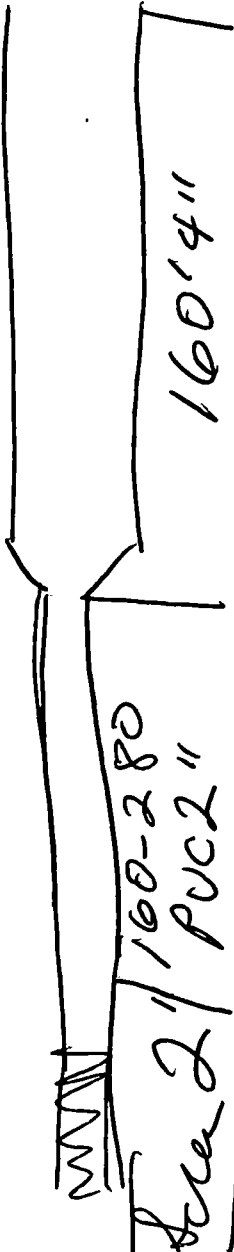

If more than one screen, show location of each on sketch.

		X	

SECTION 5

Please indicate well location X.

Pump Capacity (GPM)	No. of Stages	Setting Depth	
20	13	60	FT.

PUMP TEST

Well yielded 24 GPM with a drawdown of _____ ft. after _____ hours of pumping

LOG DATA

TYPE OF LOG RUN (Circle One): No Log Run, Electric, Gamma Ray, Density, Sonic, Neutron, Other (Describe) _____

Name of Organization Running Log

GEOLOGIC DATA (Office Use Only)

Surface Elev.	Geologic Unit	Unit Thickness	Depth to Top
Subs. SWL	Date	Analysis	Aquifer Test

Driller's Remarks

