

MISSISSIPPI  
 BOARD OF WATER COMMISSIONERS  
 416 North State Street  
 Jackson, Mississippi 39201

135

WATER WELL DRILLERS LOG

HARRISON  
 M 2599  
 7-16-75

7/16 1975 COASTAL DRILLING & SERVICE CO. *Harrison*  
 date well completed firm name county well located  
 ROUTE 1 BOX 618

LANDOWNER: *Juvenal Carrillo*  
*P.O. Box 266*  
*Juvenal, Min 38753*  
 (mailing address)


description of formations encountered	from	to
<i>Topsoil</i>	<i>1</i>	<i>5</i>
<i>Red Clay</i>	<i>5</i>	<i>10</i>
<i>fine Sand</i>	<i>10</i>	<i>25</i>
<i>Coarse white Sand</i>	<i>25</i>	<i>47</i>

WELL LOCATION:  
 sec. *12* T *7* N R *9* E  
 S W  
*W. Shreveville*  
 (distance) (direction) (nearest town)

WELL PURPOSE: *Industrial*  
 (home, irrigation, municipal, industrial)

- WELL COMPLETION DATA:
- diameter (inches) *3"*
  - total depth (feet) *47'*
  - static water level (feet) *15* below above top of ground.
  - casing *PVC* *42'*  
 (material) (depth)  
 (size) if telescope see back.
  - screen *5'* *42'*  
 (length) (depth to top)  
*2"* *PVC*  
 (size) (material)
  - pump *1/2* *12*  
 (HP) (yield gpm)  
*Ele*  
 (type power)
  - electric log *no*  
 (yes or no)  
 (organization running log)

(8) how well bottom plugged *24 feet water table*  
 DRILLERS REMARKS: *None*

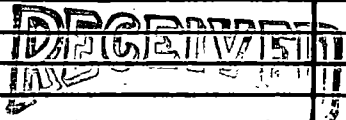

MAR 7 1976

If well telescopes please sketch and show depths.

GROUND LEVEL

	X		

SECTION \_\_\_\_\_

Please indicate well location X.

ADDITIONAL INFORMATION

If more than one screen, show locations of each on sketch.