

WATER WELL DRILLERS LOG

M.H. HAR.

W120708

C. I. SWITZER WELL CO.

Date: 5-25, 1963, Driller:

County Harrison

5-25-63

(Name)

(1) Owner of Land: Chas. Perkins
(Name)
on Highway 24
(Address)

(2) Location: $\frac{1}{4}$, $\frac{1}{4}$, Sec. 15/37T 2R 10

_____ miles _____ of _____
(distance) (direction) (Nearest Town)

(3) Topography: (Hilly) (Flat) (Level)

(4) Purpose of Well: Domestic
(Domestic Irrigation, Municipal, Industrial, Other)


Information upon completion of well:

- (1) Diameter 3x2 inches.
- (2) Total Depth 540' feet.
- (3) Water Level 96' feet below top of ground.
- (4) Cased to 540', Size 3x2"
- (5) Screen: Size 2", Length 15'
- (6) Were any formations sealed against pollution?
 yes, _____ no.

If YES depth of formation _____
Why Health Dept. requirements

Drillers Remarks: _____

Description & Color of Materials Sand, Clay, Red Clay, Shell, etc.	Thick- ness Feet	Depth Feet
clay	00	30
sand, good	30	70
clay	70	105
sand, fine	105	133
clay	133	160
clay w/ fine s. etc	160	190
clay	190	220
sand w/ fine clay etc	220	240
sand, good yellow	240	260
clay	260	320
sand	320	378
sand, good	378	412
clay	412	458
sand	458	460
sand, good	460	540

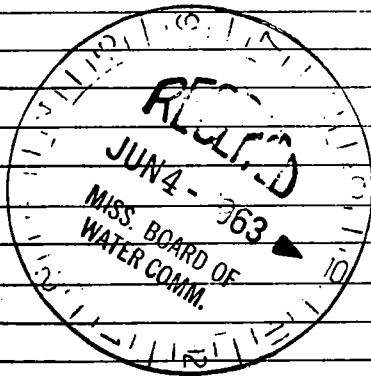

(Use Back Side)

Well No.