

TYPE II WELL CONSTRUCTION LOG

PROJECT NAME: Burns Oil Co. WELL AW-1

TOWN/CITY Diberville

COUNTY Harrison STATE MS

PERMIT NO. _____

LAND SURFACE ELEVATION AND DATUM _____ SURVEYED
 _____ ESTIMATED

INSTALLATION DATE(S) 4-23-01

DRILLING METHOD Hollow St. Auger

DRILLING CONTRACTOR _____

DRILLING FLUID _____

DEVELOPMENT TECHNIQUE(S) AND DATE(S) _____

FLUID LOSS DURING DRILLING _____ GALLONS

WATER REMOVED DURING DEVELOPMENT _____ GALLONS

SEAL WATER DEPTH _____ FEET BELOW MFL

YIELD _____ GALLONS/MINUTE (GPM)

SPECIFIC CAPACITY _____ GPM/FT

WELL PURPOSE _____


REMARKS _____

PREPARED BY _____

RECEIVED

JUN 05 2001

Dept. of Environmental Quality
Office of Land & Water Resources

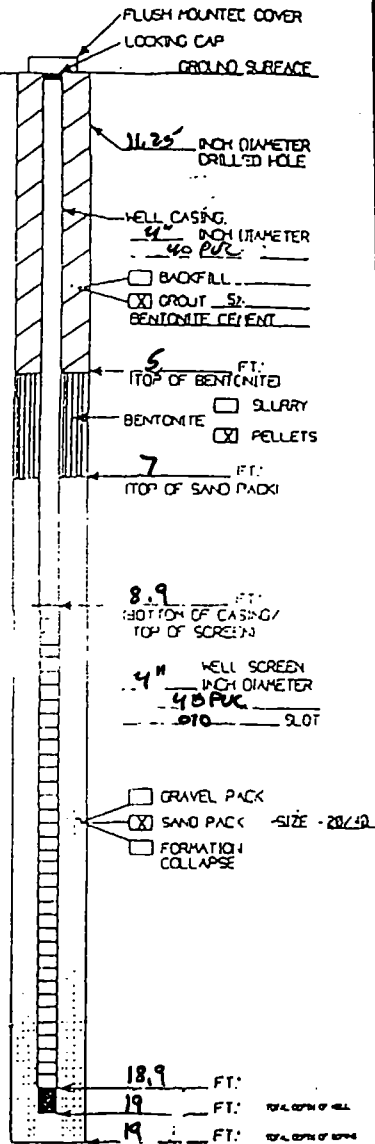

NOTE: ALL DEPTHS MEASURED RELATIVE TO GROUND SURFACE
 NM - NOT MEASURED

