

TYPE II WELL CONSTRUCTION LOG

PROJECT NAME: Buen's Oil Co. WELL RW 2

TOWN/CITY D'Iberville

COUNTY Lewis STATE MS

PERMIT NO. _____

LAND SURFACE ELEVATION AND DATUM _____ SURVEYED
 _____ ESTIMATED

INSTALLATION DATE(S) 4-23-01

DRILLING METHOD Hollow Stem Auger

DRILLING CONTRACTOR _____

DRILLING FLUID _____

DEVELOPMENT TECHNIQUE(S) AND DATE(S) _____

FUEL OILS DURING DRILLING _____ GALLONS

WATER REMOVED DURING DEVELOPMENT _____ GALLONS

STATIONARY WATER DEPTH _____ FEET BELOW MSL

YIELD _____ GALLONS/MINUTE (GPM)

SPECIAL CAPACITY _____ GPM/FT


WELL PURPOSE _____

REMARKS _____

PREPARED BY _____

RECEIVED
 JUN 05 2001

Dept. of Environmental Quality
 Office of Land & Water Resources

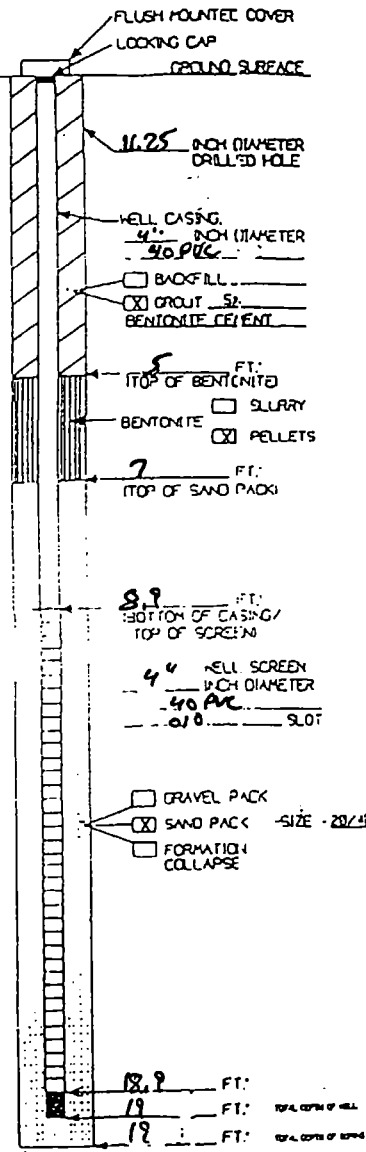

NOTE: ALL DEPTHS MEASURED RELATIVE TO GROUND SURFACE
 NH - NOT MEASURED

