

# TYPE II WELL CONSTRUCTION LOG

PROJECT NAME: Baca's Oil Co. WELL RW-3

TOWN/CITY Deerfield

COUNTY Harrison STATE MS.

PERMIT NO. \_\_\_\_\_

LAND SURFACE ELEVATION AND DATUM \_\_\_\_\_  SURVEYED  
 \_\_\_\_\_  ESTIMATED

INSTALLATION DATE(S) 4-23-01

DRILLING METHOD Hollow Stem Auger

DRILLING CONTRACTOR \_\_\_\_\_

DRILLING FLUID \_\_\_\_\_

DEVELOPMENT TECHNIQUE(S) AND DATE(S) \_\_\_\_\_

FLUID LOSS DURING DRILLING \_\_\_\_\_ GALLONS

WATER REMOVED DURING DEVELOPMENT \_\_\_\_\_ GALLONS

STABLE WATER DEPTH \_\_\_\_\_ FEET BELOW MSL

YIELD \_\_\_\_\_ GALLONS/MINUTE (GPM)


SPECIAL CAPACITY \_\_\_\_\_ GPM/FT

WELL PURPOSE \_\_\_\_\_

REMARKS \_\_\_\_\_

**RECEIVED**  
 JUN 05 2001

PREPARED BY: Dept. of Environmental Quality  
 Office of Land & Water Resources

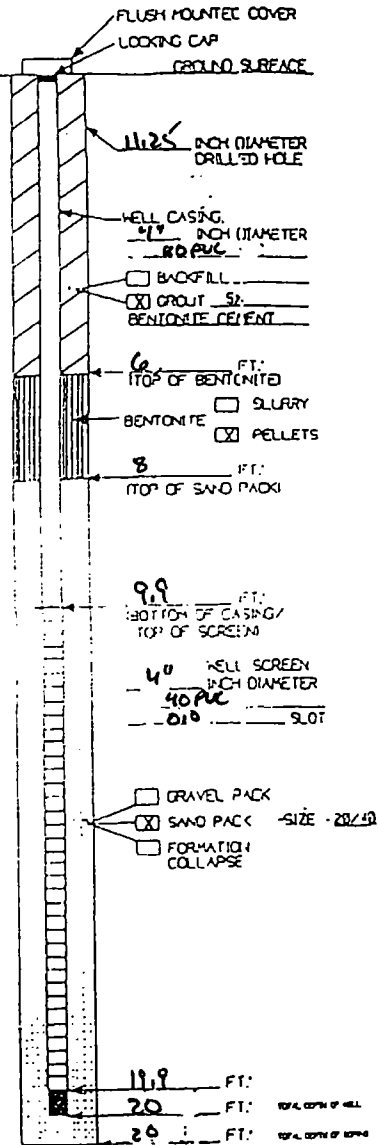

NOTE: ALL DEPTHS MEASURED RELATIVE TO GROUND SURFACE  
 NH - NOT MEASURED

