

# TYPE II WELL CONSTRUCTION LOG

PROJECT NAME: Burns Site WELL RW-4

TOWN/CITY D'Iberville

COUNTY Harrison STATE MS

PERMIT NO. \_\_\_\_\_

LAND SURFACE ELEVATION AND DATUM \_\_\_\_\_  SURVEYED  
 \_\_\_\_\_ NGVD FEET  ESTIMATED

INSTALLATION DATE(S): 4-23-01

DRILLING METHOD Hollow Stem Auger

DRILLING CONTRACTOR \_\_\_\_\_

DRILLING FLUID \_\_\_\_\_

DEVELOPMENT TECHNIQUE(S) AND DATE(S) \_\_\_\_\_

FLUID USED DURING DRILLING \_\_\_\_\_ GALLONS

WATER REMOVED DURING DEVELOPMENT \_\_\_\_\_ GALLONS

STATIC WATER DEPTH \_\_\_\_\_ FEET BELOW MSL

YIELD \_\_\_\_\_ GALLONS/MINUTE (GPM)

SPECIFIC CAPACITY \_\_\_\_\_ GPM/FT


WELL PURPOSE \_\_\_\_\_

REMARKS \_\_\_\_\_

**RECEIVED**  
 JUN 05 2001

PREPARED BY: \_\_\_\_\_

Dept of Environmental Quality  
 Office of Land & Water Resources

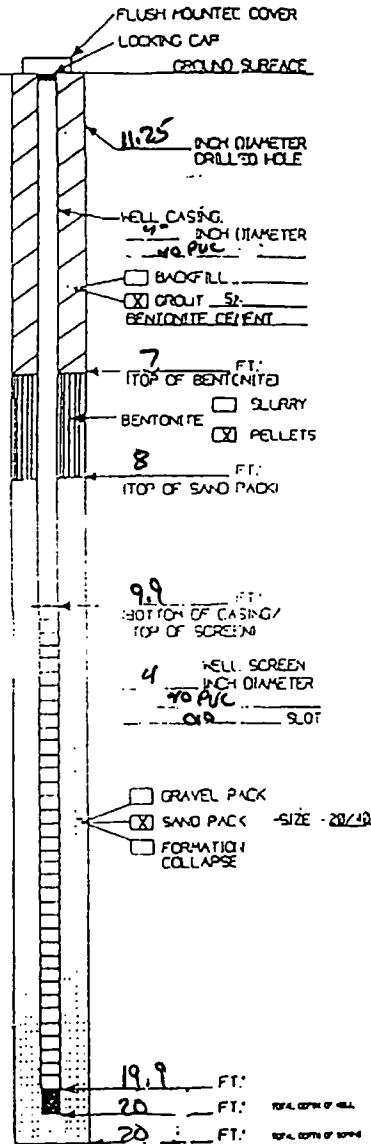

NOTE: ALL DEPTHS MEASURED RELATIVE TO GROUND SURFACE  
 NM - NOT MEASURED

