

Harrison

MISSISSIPPI DEPARTMENT OF NATURAL RESOURCES

Bureau of Land and Water Resources

P.O. Box 10631

Jackson, Mississippi 39209

WATER WELL DRILLERS LOG

COUNTY WELL LOCATED
Jackson
 WELL NUMBER **M** CODED
 DATE WELL COMPLETED
10-14-88

PERMIT NUMBER
 NAME OF DRILLING FIRM
Coast Water Well Service Inc.

NAME & MAILING ADDRESS OF LANDOWNER
Albert Arguelles
Country Club Lane
Bucari Mo 39532
 WELL LOCATION: SEC **11** TOWNSHIP **7** RANGE **10**
S **E**
 DISTANCE **2 1/2** MILES DIRECTION **NORTH** NEAREST TOWN **B. 16X1**
 OTHER LANDMARK
 WELL PURPOSE: Home, Irrigation, Municipal, Industrial, Fish Pond, etc.
home.

PUMP DATA
 PUMP TYPE (Circle One):
 Submersible, Turbine, Jet, Flowing Well,
 Other (Describe) _____
 POWER TYPE (Circle One):
 Electric, Tractor, Diesel, Gasoline, Butane,
 Other (Describe) _____
 Pump Capacity (GPM) _____ No. of Stages _____ Setting Depth _____ FT.
 PUMP TEST
 Well yielded _____ GPM with
 a drawdown of _____ ft.
 after _____ hours of pumping

WELL DATA
 Well Depth **530** Casing Diameter (In.) **2"** Casing Length (Ft.) **505'**
 Type of Casing **PVC** Hole Depth **530** Depth to Static Water Level **45'**
 TYPE OF COMPLETION: (Circle One or More):
 Gravel Packed, Underreamed, Telescoped,
 Natural Development, Open Hole, Other
 (Describe) _____
 Top of Lap Pipe or Reduction in Casing
 FEET IF TELESCOPED OR MORE THAN ONE SCREEN: USE BACK PAGE

LOG DATA
 TYPE OF LOG RUN (Circle One): **No Log Run,**
 Electric, Gamma Ray, Density, Sonic, Neutron,
 Other (Describe) _____
 Name of Organization Running Log

SCREEN DATA
 Diameter - Inches **2"** Length - Feet **20'** Slot Size - Inches **.008**
 Screen Type **PVC** Depth to Bottom - Feet **325'**

GEOLOGIC DATA (Office Use Only)

Surface Elev.	Geologic Unit	Unit Thickness	Depth to Top
Subs. SWL	Date	Analysis	Aquifer Test

Driller's Remarks

RECEIVED

DESCRIPTION OF FORMATIONS ENCOUNTERED	FROM	TO	FORMATIONS (Continued)	FROM	TO
Top Soil	0	2			
Brown Clay	2	23			
White Coarse Sand & Gravel	23	43			
Blue Clay	43	60			
White Coarse Sand	60	80			
Blue Clay	80	110			
Fine Gray Sand	110	120			
Blue Clay	120	444			
Med Gray Sand	444	530			


NOV 17 1988

Department of Natural Resources
Bureau of Land & Water Resources

IF MORE SPACE IS NEEDED, USE BACK

If well telescopes please sketch and show depths.

GROUND LEVEL

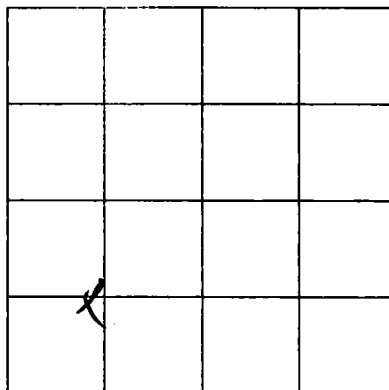

SECTION

11

Please indicate well location X.

ADDITIONAL INFORMATION

If more than one screen,
show location of each on sketch.