

M.
10-19-64

D 92103

WATER WELL DRILLERS LOG

CODED

Date: 10-19, 1964, Driller: C. T. SWITZER WELL CO. County: Harrison

(Name)

(1) Owner of Land: Paul H. Campbell
(Name)
402 - Delmar, Harrison
(Address)

(2) Location: 33 710
1/4, 1/4, Sec. T R
miles of
(distance) (direction) (Nearest Town)

(3) Topography: R
(Hilly) (Flat) (Level)

(4) Purpose of Well: Domestic
(Domestic Irrigation
Municipal, Industrial, Other)

Description & Color of Materials Sand, Clay, Red Clay, Shell, etc.	Thick- ness Foot	Depth Foot
sand	0	12
sand & clay s&s	12	63
sand & pea gravel	63	84
sand & gravel	84	136
clay	136	205
sand	205	210
sand, real fine	210	231
clay	231	252
clay & sand s&s	252	273
clay	273	315
clay w/ few sand s&s	315	336
clay	336	420
clay & shells	420	441
clay	441	504
clay & few sand s&s	504	546
sand & clay s&s	546	567
clay	567	577
sand	577	588
sand, good	588	640

Information upon completion of well:

(1) Diameter 2" inches.

(2) Total Depth 640 feet.

(3) Water Level 14' feet below top of ground.

(4) Cased to 640', Size 2"

(5) Screen: Size 2", Length 10'


(6) Were any formations sealed against pollution?
✓ yes, no.

If YES depth of formation _____

Why Health Dept. requirement

Drillers Remarks: _____

CODED

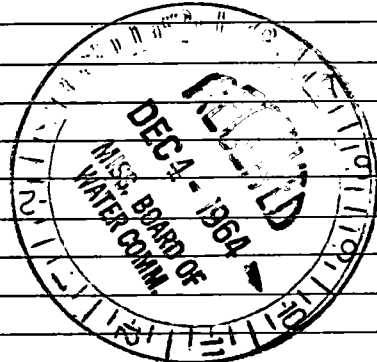

(Use Back Side)

Well No.

