

CODED

WATER WELL DRILLERS LOG

M
4-4-63
Date: Apr. 4, 1963, Driller: L. L. Garland County Harrison
(Name)

(1) Owner of Land:	Description & Color of Materials Sand, Clay, Red Clay, Shell, etc.	Thick- ness Feet	Depth Feet
<u>Ed. Harvey</u> (Name) <u>N. Biloxi, Miss.</u> (Address)			
(2) Location: _____ 1/4, _____ 1/4, Sec. <u>32 T 6 S 9 W</u> _____ miles _____ of _____ (distance) (direction) (Nearest Town)	1 <u>Clay</u>		
(3) Topography: _____ (Hilly) (Flat) (Level)	2 <u>Sand</u>		
(4) Purpose of Well: <u>Dom.</u> (Domestic Irrigation Municipal, Industrial, Other)	3 <u>Mix.</u>		
	4 <u>"</u>		
	5 <u>"</u>		
	6 <u>mud</u>		
	7 <u>Mix.</u>		
	8 <u>Sand</u>		
	9 <u>4' Sand</u>		


Information upon completion of well:

- (1) Diameter _____ inches.
- (2) Total Depth 172 feet.
- (3) Water Level 13 1/2 feet below top of ground.
- (4) Cased to _____, Size _____.
- (5) Screen: Size .08, Length 10'.
- (6) Were any formations sealed against pollution?
 _____ yes, _____ no.

If YES depth of formation _____

Why _____

Drillers Remarks: _____

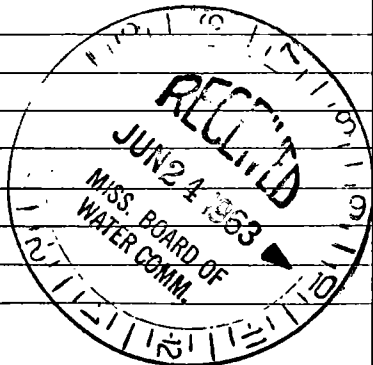

(Use Back Side)

Well No.

