

Harrison
M1
4-66

MISSISSIPPI BOARD OF WATER COMMISSIONERS

WATER WELL DRILLERS LOG

Date: 4-6-66, 19, Driller: C.T. Bentger Well Co. County Harrison
(Name)

(1) Owner of Land: Maxon Land Co.
(Name)
East Beach, Belzoni Miss
(Address)

(2) Location: 1/4, 1/4, Sec. T. R.
miles of of
(distance) (direction) (Nearest Town)

(3) Topography: X
(Hilly) (Flat) (Level)

(4) Purpose of Well: Commercial
(Domestic Irrigation
Municipal, Industrial, Other)

Information upon completion of well:

(1) Diameter 8" x 12" inches.

(2) Total Depth 1002 feet.

(3) Water Level 7' 6" + feet below top of ground.
to 104' - 12"

(4) Cased to 1002, Size 8" x 12".

(5) Screen: Size 20' 8" x 1/2" Length 60'
40' 1/2" x 1/2"


(6) Were any formations sealed against pollution?
X yes, no.

If YES depth of formation

Why Health Dept. Requirements

Drillers Remarks:

Description & Color of Materials Sand, Clay, Red Clay, Shell, etc.	Thick- ness Feet	Depth Feet
<u>Opaline shell</u>	<u>0</u>	<u>6</u>
<u>Clay</u>	<u>6</u>	<u>26</u>
<u>Sand</u>	<u>26</u>	<u>39</u>
<u>Clay</u>	<u>39</u>	<u>52</u>
<u>Mixed sand & clay</u>	<u>52</u>	<u>85</u>
<u>Soft clay</u>	<u>85</u>	<u>107</u>
<u>Sand</u>	<u>107</u>	<u>121</u>
<u>Mixed</u>	<u>121</u>	<u>150</u>
<u>Clay</u>	<u>150</u>	<u>173</u>
<u>Mixed</u>	<u>173</u>	<u>240</u>
<u>Clay</u>	<u>240</u>	<u>244</u>
<u>Rock</u>	<u>244</u>	<u>246</u>
<u>Clay</u>	<u>246</u>	<u>261</u>
<u>Hard clay</u>	<u>261</u>	<u>284</u>
<u>Clay + shale</u>	<u>284</u>	<u>331</u>
<u>Clay</u>	<u>331</u>	<u>358</u>
<u>Sand</u>	<u>358</u>	<u>366</u>
<u>Clay</u>	<u>366</u>	<u>375</u>
<u>Sand</u>	<u>375</u>	<u>385</u>
<u>Clay</u>	<u>385</u>	<u>418</u>
<u>Clay + sand silt</u>	<u>418</u>	<u>460</u>
<u>Clay</u>	<u>460</u>	<u>471</u>
<u>Sand</u>	<u>471</u>	<u>482</u>
<u>Sand + shale</u>	<u>482</u>	<u>505</u>
<u>Sand</u>	<u>505</u>	<u>515</u>
<u>Rock</u>	<u>515</u>	<u>525</u>
<u>Clay</u>	<u>525</u>	<u>528</u>
<u>Clay + shale</u>	<u>528</u>	<u>550</u>
<u>Clay</u>	<u>550</u>	<u>593</u>
<u>Mixed</u>	<u>593</u>	<u>616</u>
<u>Shale</u>	<u>616</u>	<u>626</u>
<u>Sand</u>	<u>626</u>	<u>639</u>

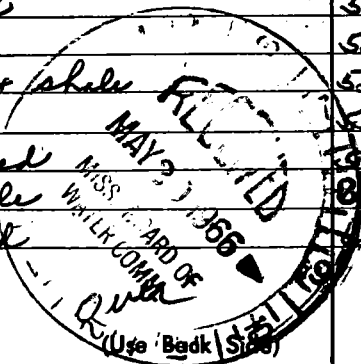

Well No.

Clay	639-654
Sand	654-660
Sand, fine	660-681
Sand	681-694
Clay	694-704
Sand	704-808
Clay	808-811
Mixed	811-856
Sand, good	856-901
Sand	901-913
Clay	913-930
Sand	930-990
Sand, good	990-1002