

HAR.

MISSISSIPPI BOARD OF WATER COMMISSIONERS

M

7-26-63

WATER WELL DRILLERS LOG

C. T. SWITZER WELL CO.

Date: 7/26, 1963, Driller: [Signature], County: Harrison

(Name)

(1) Owner of Land: Robert Whittington  
 (Name)  
Highway 90, Co. 2nd part  
 (Address)

(2) Location: 1/4, 1/4, Sec. T R  
 (distance) (direction) (Nearest Town)

(3) Topography:  (Hilly)  (Flat)  (Level)

(4) Purpose of Well: Commercial  
 (Domestic Irrigation, Municipal, Industrial, Other)

Description & Color of Materials Sand, Clay, Red Clay, Shell, etc.	Thick- ness Feet	Depth Feet
sand	39	39
mud	39	45
sand	45	63
clay	63	76
clay w/ sand shls	76	109
clay	109	132
clay w/ sand shls	132	155
clay	155	178
clay w/ sand shls	178	200
sand, fine	200	234
clay, fine	234	266
sand, fine	266	270
sand	270	284
clay	284	313
soft mud	313	334
clay	334	378
shale	378	422
sand, fine	422	466
sand	466	498
clay	498	510
shale w/ sand shls	510	531
shale & sand shls	531	554
shale & sand shls	554	567
sand	567	667

Information upon completion of well:

(1) Diameter: 12 1/2 inches.

(2) Total Depth: 667 feet.

(3) Water Level: 16' feet below top of ground.

(4) Cased to: 662', Size: 12 1/2"


(5) Screen: Size: 8", Length: 60'

(6) Were any formations sealed against pollution?  
 yes,  no.

If YES depth of formation \_\_\_\_\_

Why: Health Dept. requirement

Drillers Remarks: \_\_\_\_\_

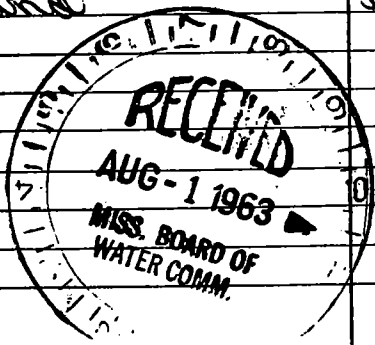

(Use Back Side)

Well No.

