

HAR.  
M

MISSISSIPPI BOARD OF WATER COMMISSIONERS

2-17-61

WATER WELL DRILLERS LOG

0-312

Date: 2-17, 1961, Driller: Sutter Well Works County Harrison  
(Name)

(1) Owner of Land: H. H. Leggett  
(Name)  
Gulfport, Miss.  
(Address)

(2) Location: 1/4, 1/4, Sec. 21 7 11  
T R  
1 miles N, of Hanksboro  
(distance) (direction) (Nearest Town)

(3) Topography: flat  
(Hilly) (Flat) (Level)

(4) Purpose of Well: domestic  
(Commercial) (Domestic Irrigation) (Municipal, Industrial, Other)


Description & Color of Materials Sand, Clay, Red Clay, Shell, etc.	Thick- ness Feet	Depth Feet
<u>Fine Sand, white Clay</u>	<u>50</u>	<u>50</u>
<u>sand &amp; gravel</u>	<u>67</u>	<u>117</u>
<u>Clay</u>	<u>108</u>	<u>225</u>
<u>sand</u>	<u>62</u>	<u>287</u>
<u>Clay</u>	<u>12</u>	<u>299</u>
<u>sand</u>	<u>31</u>	<u>330</u>
<u>Clay</u>	<u>105</u>	<u>435</u>
<u>sand</u>	<u>17</u>	<u>452</u>
<u>Clay</u>	<u>71</u>	<u>523</u>
<u>sand</u>	<u>94</u>	<u>617</u>
<u>Clay</u>	<u>23</u>	<u>640</u>
<u>sand</u>	<u>115</u>	<u>755</u>

Information upon completion of well:

- (1) Diameter 6 x 4 inches.
- (2) Total Depth 755 feet.
- (3) Water Level 9 feet above below top of ground.
- (4) Cased for all, Size top 100'-6" below 4".
- (5) Screen: Size 4", Length 30'.
- (6) Were any formations sealed against pollution?  
 yes,  no.

If YES depth of formation top 15 feet  
Why Owner's request.

Drillers Remarks:

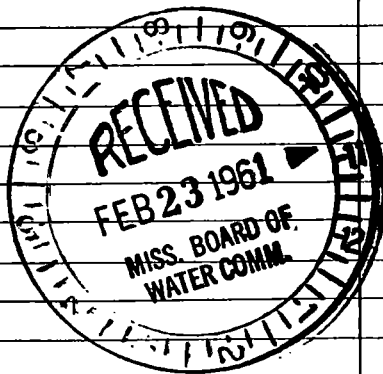

(Use Back Side)

Well No.

