

HAR.

MISSISSIPPI BOARD OF WATER COMMISSIONERS

M

7-5-60

WATER WELL DRILLERS LOG

M-

Date: 7-5, 1960, Driller: SUTTER WELL WORKS County HARRISON

(Name)

(1) Owner of Land: JACK FAIRCHILD (Name)

MISSISSIPPI CITY, MISS. (Address)

(2) Location: 1/4, 1/4, Sec. T R

miles (distance), IN (direction), of City (Nearest Town)

(3) Topography: flat (Hilly) (Flat) (Level)

(4) Purpose of Well: tourist Court (Domestic Irrigation, Municipal, Industrial, Other)

Description & Color of Materials Sand, Clay, Red Clay, Shell, etc.

Thick-ness Feet

Depth Feet

Sand		32
Clay - Sand streaks	324	356
Sand	50	406
Clay	256	662
Redd	52	714
Clay streaks	129	841
Sand	65	906

Information upon completion of well:

(1) Diameter 4 inches.

(2) Total Depth 906 feet.

(3) Water Level 31 feet above below top of ground.

(4) Cased or all, Size 4"

(5) Screen: Size 4", Length 40'


(6) Were any formations sealed against pollution?

yes, no.

If YES depth of formation

Why


Drillers Remarks:

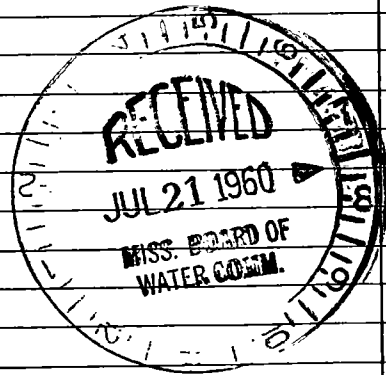

(Use Back Side)

Well No.

Handwritten text at the top of the page, possibly a title or header, which is mostly illegible due to the high contrast and noise of the scan.

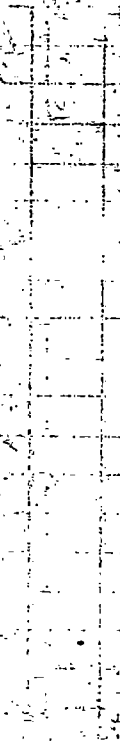

Handwritten text in the upper right quadrant of the page, possibly a date or a reference number.