

HAR.

MISSISSIPPI BOARD OF WATER COMMISSIONERS

M

WATER WELL DRILLERS LOG

M-

7-14-60

Date: July 14, 1960, Driller: C. J. Switzer Well Co. County Harrison

(Name)

(1) Owner of Land: Henry E. Krohn
 Highway 67-Rt. 11 Box 550 Biloxi
 (1st house north of drag strip)
 (Address)

(2) Location: 1/4, 1/4, Sec. T R
10 miles NW of Biloxi
 (distance) (direction) (Nearest Town)

(3) Topography: (Hilly) (Flat) (Level)

(4) Purpose of Well: Domestic
 (Domestic Irrigation
 Municipal, Industrial, Other)

| Description & Color of Materials Sand, Clay, Red Clay, Shell, etc. | Thick- ness Feet | Depth Feet |
|-----------------------------------------------------------------------|------------------------|---------------|
| Red surface clay | 12 | 12 |
| sand, surface | 16 | 28 |
| Blue clay | 80 | 108 |
| sand, fine | 18 | 126 |
| clay | 126 | 266 |
| sand, coarse | 32 | 298 |


Information upon completion of well:

- (1) Diameter 2 inches.
- (2) Total Depth 298 feet.
- (3) Water Level 5' + feet below top of ground.
- (4) Cased to 298', Size 2"
- (5) Screen: Size 010.00, Length 15'
- (6) Were any formations sealed against pollution?
 yes, no.

If YES depth of formation 10 feet

Why Health Dept. requirement

Drillers Remarks:

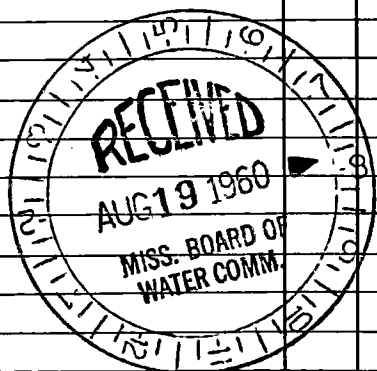

(Use Back Side)

Well No.

Handwritten text at the top of the page, possibly a title or header.

A vertical grid structure on the left side of the page, possibly a table or a form. It consists of a vertical line on the left and several horizontal lines extending to the right, creating a series of rectangular cells. The grid is partially obscured by noise and artifacts.

Handwritten text at the bottom of the page, possibly a signature or footer.