

HAR.

MISSISSIPPI BOARD OF WATER COMMISSIONERS

M  
7-18-60

WATER WELL DRILLERS LOG

M-1-1-1-1-1

Date: July 18 19 60, Driller: C. J. Smitz Well County Harrison  
(Name)

- (1) Owner of Land: L. J. Duave  
D'Arville - 13<sup>(Name)</sup> House north  
of Five Point Shell Station  
(Address)
- (2) Location: 1/4, 1/4, Sec. T R R  
2 miles N, of Biloxi  
(distance) (direction) (Nearest Town)
- (3) Topography:  (Hilly)  (Flat)  (Level)
- (4) Purpose of Well: Domestic  
(Domestic Irrigation  
Municipal, Industrial, Other)

Description & Color of Materials Sand, Clay, Red Clay, Shell, etc.	Thick-ness Feet	Depth Feet
<u>Surface clay</u>	<u>22</u>	<u>22</u>
<u>Red &amp; Yellow sand</u>	<u>6</u>	<u>28</u>
<u>Blue clay</u>	<u>374</u>	<u>412</u>
<u>Coarse sand</u>	<u>18</u>	<u>430</u>


Information upon completion of well:

- (1) Diameter 2 inches.
- (2) Total Depth 430 feet.
- (3) Water Level 2' 7" feet below top of ground.
- (4) Cased to 430', Size 2"
- (5) Screen: Size 80000, Length 10'
- (6) Were any formations sealed against pollution?  
 yes,  no.

If YES depth of formation 10 feet

Why Health Dept. requirement

Drillers Remarks:

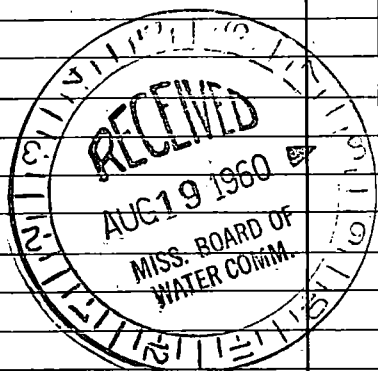

(Use Back Side)

Well No.

Faint handwritten text at the top of the page, possibly a title or header, which is mostly illegible due to fading and bleed-through.

Second section of faint handwritten text, appearing as a list or series of entries, with some words like "ITEM" or "NO." partially visible.





Bottom section of faint handwritten text, possibly a summary or conclusion, with some illegible words and numbers.