

HAR.
M

W 138 404
WATER WELL DRILLERS LOG

M-3

11-16-60

Date: 11-16, 1960, Driller: C.T. Switzer Well County Harrison
(Name)

	Description & Color of Materials Sand, Clay, Red Clay, Shell, etc.	Thick- ness Feet	Depth Feet
(1) Owner of Land: <u>A. D. Hagler</u> <u>End of Shell Rd. in Highland</u> <u>Area Sub. by Campbell-Northway</u> (Address) <u>Buck Bay</u>	Sand	0	42
(2) Location: _____ 1/4, _____ 1/4, Sec. _____ T R _____	Clay	40	54
3 miles <u>N.W.</u> of <u>Beltop</u> (distance) (direction) (Nearest Town)	Sand	54	65
(3) Topography: <u>Sloping</u> (Hilly) (Flat) (Level)	Clay	65	76
(4) Purpose of Well: <u>domestic</u> (Domestic Irrigation Municipal, Industrial, Other)	Sand	76	86
	Clay	86	292
	Sand	292	299
	Clay	299	319
	Sand	319	376


Information upon completion of well:

- (1) Diameter 2 inches.
- (2) Total Depth 376 feet.
- (3) Water Level 8' 7" feet below top of ground.
- (4) Cased to 376', Size 2"
- (5) Screen: Size 2" sq Length 10'
- (6) Were any formations sealed against pollution?
 yes, no.

If YES depth of formation 10 feet

Why Health dept. requirement

Drillers Remarks:

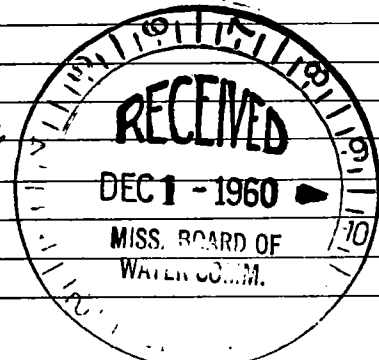

(Use Back Side)

Well No.

11-12

