

HAR.

M

10-20-60

WATER WELL DRILLERS LOG

M--

Date: 10-20, 1960, Driller C. T. Siviter Well Co County Harrison
 (Name)

(1) Owner of Land: Alan Huffstetter
 (Name)
Pass Rd - Biloxi
 (Address)

(2) Location: 1/4, 1/4, Sec. T R
3 miles W of Biloxi
 (distance) (direction) (Nearest Town)

(3) Topography: ✓
 (Hilly) (Flat) (Level)

(4) Purpose of Well: Domestic
 (Domestic Irrigation
 Municipal, Industrial, Other)

Description & Color of Materials Sand, Clay, Red Clay, Shell, etc.	Thick- ness Feet	Depth Feet
<u>Sand</u>	<u>0</u>	<u>58</u>
<u>Clay</u>	<u>38</u>	<u>60</u>
<u>sand</u>	<u>60</u>	<u>65</u>
<u>Clay</u>	<u>65</u>	<u>79</u>
<u>sand</u>	<u>79</u>	<u>95</u>

Information upon completion of well:

(1) Diameter 3 inches.

(2) Total Depth 95 feet.

(3) Water Level 21' 2" feet below top of ground.


(4) Cased to 95', Size 5"

(5) Screen: Size 3", Length 10'

(6) Were any formations sealed against pollution?
✓ yes, no.

If YES depth of formation 10 feet
 Why Health Dept. Requirement

Drillers Remarks:

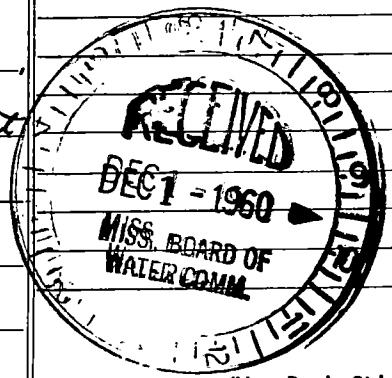

Well No.

