

HAR.

M

8-23-60

WATER WELL DRILLERS LOG

M - -

Date: 8-23, 1960, Driller: L. T. Switzer Well Co. County Harrison

(Name)

(1) Owner of Land: M. D. Quincey, Jr.
(Name)
On Gay Rd. 1/4 mile south of
Cedar Lake Road
(Address)

(2) Location: 1/4, 1/4, Sec. T R
3 miles N, of Biloxi
(distance) (direction) (Nearest Town)

(3) Topography: (Hilly) (Flat) (Level)

(4) Purpose of Well: domestic
(Domestic Irrigation Municipal, Industrial, Other)

Description & Color of Materials Sand, Clay, Red Clay, Shell, etc.	Thick- ness Feet	Depth Feet
Clay	0	54
good sand	54	70
Coarse sand	70	93
Clay	93	142
fine sand	142	148
Clay	148	164
fine sand	164	195
Clay	195	277
Med. fine sand	277	305

Information upon completion of well:

(1) Diameter 2 inches.

(2) Total Depth 305 feet.

(3) Water Level 29' feet below top of ground.

(4) Cased to 305', Size 2"


(5) Screen: Size 2", Length 10'55

(6) Were any formations sealed against pollution?
 yes, no.

If YES depth of formation 10 feet

Why Health Dept. Requirement

Drillers Remarks: _____

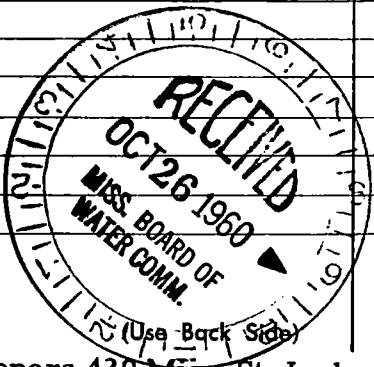

Well No. _____

