

HAR.

MISSISSIPPI BOARD OF WATER COMMISSIONERS

M

WATER WELL DRILLERS LOG

M - -

8-15-60

Date: 8-15, 1960, Driller: Joseph O. Melh County Harrison (Name)

(1) Owner of Land: R C King  
 (Name)  
Popp Ferry Rd,  
 (Address)

(2) Location: 1/4, 1/4, Sec.      T      R       
6 miles N.W., of Belokel  
 (distance) (direction) (Nearest Town)

(3) Topography: Flat  
 (Hilly) (Flat) (Level)

(4) Purpose of Well: Domestic  
 (Domestic Irrigation  
 Municipal, Industrial, Other)

Description & Color of Materials Sand, Clay, Red Clay, Shell, etc.	Thick- ness Feet	Depth Feet
<u>Black Soil</u>	<u>8</u>	<u>8</u>
<u>Gray Blue Clay</u>	<u>102</u>	<u>110</u>
<u>Red Clay Sand Wood etc</u>	<u>46</u>	<u>156</u>
<u>Blue Clay</u>	<u>137</u>	<u>293</u>
<u>Small Blue Gray Sand</u>	<u>5</u>	<u>298</u>
<u>Hard Clay Blue</u>	<u>22</u>	<u>320</u>
<u>Break (Fine Sand)</u>	<u>5</u>	<u>325</u>
<u>Gray sand</u>	<u>10</u>	<u>335</u>
<u>Gray sand</u>	<u>21</u>	<u>356</u>

Hard Blue Clay

Information upon completion of well:

(1) Diameter 2 inches.

(2) Total Depth 356 feet.

(3) Water Level 8' feet below top of ground.

(4) Cased to 346, Size 2"


(5) Screen: Size 2", Length 10'

(6) Were any formations sealed against pollution?  
 \_\_\_\_\_ yes, \_\_\_\_\_ no.

If YES depth of formation \_\_\_\_\_

Why \_\_\_\_\_

Drillers Remarks: \_\_\_\_\_

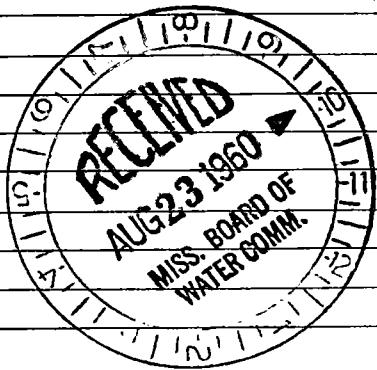

over

(Use Back Side)

Well No.

